

Morton

KANSAS

SECTION 20 TOWNSHIP 34 RANGE 43 WWELL NO. #1 InterstateCOMPANY Panhandle Eastern

NORTH

WEST								EAST

SOUTH

Morton

KANSAS

SEC.

20

TWP.

34

R.

43W

WELL NO.

#1 Interstate

FARM

COMPANY

Panhandle Eastern

CONTRACTOR

Musgrove
Greenwood

Ft. from N. Line

1680'


Ft. from S. Line

2490'

Ft. from E. Line

Ft. from W. Line

SW NW SE

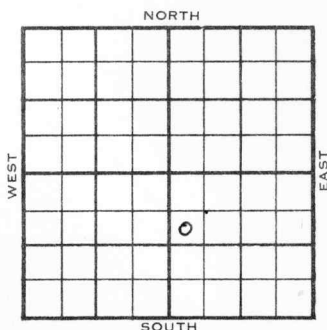

1955

ELEVATION

3477

REPORT

11/2

M I R

12-28

Comm. 11-1-55

13 3/8" @ 96/100

8 5/8" @ 583/300

5 1/2" @ 2964/275

CO to 2945, 16/ 2908-12, 20/ 2899-2904

1000 A, 3,188 mcfg 8 hrs., BD

PB 2870, 30/ 2837-42, 24/ 2801-05,

24/ 2792-96, 48/ 2780-88, 20/ 2771-76

2000 A, 4 hrs., BD, 427 mcfg, 7 hrs.

BD 11,430 mcfg,

PB 2755, 30/ 2730-45, 60/ 2718-28,

1,286 mcfg, 24/ 2690-94, 24/ 2606-10

2000 A, 12,437 mcfg, 2000 A, CO

4000 A, 4 hrs., BD 29,175 mcfg

Comp. 12,272 mcfgpd

Waub. 2472 Log tops:

Top 2663

Greenwood 2893

TD 2985'

COMPLETED

County Morton Elev. 43W
 Sec. 20 Twp. 34 Rge. 43W
 Company Panhandle Eastern
 Farm Name Interstate No. 1

TOPS	DEPTH	LOG	DATUM	Loc. in Sec.
Anh.				SW NW SE
Tp.				1680' SL
H.				2490' EL
Tr.				
Dg.				
Bl.				
L.				Geol.
K.C.				Contr.
B.K.C.				Musgrove
Ce.				
C.				Pool
M.				Greenwood
M.				
K.				
Mz.				
Mq.				
V.				
S.				
S.				
A.				
R.				
Pe.				
G.				
T.D.				

NOV 2 1955	
FIRST REPORT	

Date Comm. MIR

34

County Morton Elev. 3477
 Sec. 20 Twp. 34 Rge. 43W
 Company Panhandle Eastern
 Farm Name Interstate No. 1

TOPS	DEPTH	LOG	DATUM	Loc. in Sec.
Anh.				SW NW SE
Tp.				
H. <u>Waub</u>		<u>2472</u>		1680' SL
Tr. <u>Top</u>		<u>2663</u>		
Dg. <u>Greenwood</u>		<u>2893</u>		2490' EL
BL.				
L.				
K.C.				Geol.
B.K.C.				Contr.
Ce.				<u>Musgrove</u>
C.				
M.				
M.				Pool
K.				<u>Greenwood</u>
Mz.				
Mq.				
V.				
S.				
S.				
A.				
R.				
Pe.				
G.				
T.D.	<u>2985</u>			



Date Comm. 11-1-55 DEC 28 1955

13 3/8" @ 96/100 8 5/8" @ 583/300

5 1/2" @ 2964/275 CO to 2945 16/ 2908-12

20/ 2899-2904 1000 A 3,188 mcfg

8 hr. BD PB 2870 30/ 2837-42

24/ 2801-05 24/ 2792-96 48/ 2780-88

20/ 2771-76 2000 A 4 hr. BD 427 mcfg

7 hr. BD 11,430 mcfg PB 2755 30/ 2730-45

60/ 2718-28 1,286 mcfg 24/ 2690-94

24/ 2606-10 2000 A 12,437 mcfg
2000 A CO 4000 A 4 hr. BD 29,175 mcfg
Comp. 12,727 mcfgpd

R. G.

JAN 6 1956