

Barton KANSAS

Section 23 Township 19 Range 12W

Well No. #7 Lanterman

Company Hannum Drlg.

NORTH

6

WEST

EAST

SOUTH

o

Sec. 23 Twp. 19 R. 12W ✓

Well No. #7 Lanterman Farm

Hannum Drllg. Company

Hammer, North Contractor


 Ft. from N. Line

990' Ft. from S. Line

330' Ft. from E. Line

 Ft. from W. Line

NE SE NW

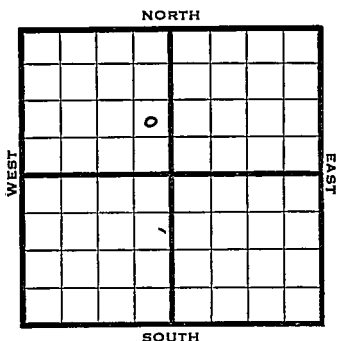

1960 Elev. 1825' REPORT

4/19 Location

5/31 8" @ 233'
Anhy 650'
KC 3110
Cong. 3387'
Arb. 3408'
5" @ 3500
TD 3660'
24/3405-12 SQ
250 A
Comp. 50 BOPD

COMPLETED

Map No. _____ Sec. 23 Twp. 19 R. 12WWell No. 7 Lanterman

_____ Hannum Drlg. _____ Company

_____ Contractor

NE SE NW


SECTION PLAT

_____ Ft. from N. Line

990 Ft. from S. Line330 Ft. from E. Line

_____ Ft. from W. Line

Barton County

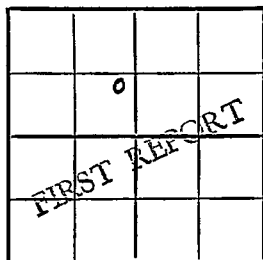Location X

Rig up _____

Drilling and Remarks: _____

RECORD

Cased _____ in., _____ ft.

Sand _____

Gas _____

Oil _____

Total Depth _____

PRODUCTION

1st 24 hrs. Nat. _____

1st 24 hrs. after shot _____

Gas _____ Cu. Ft.

Dry Hole _____

Abandoned _____

Date

APR 19 1950J. E. TYRA Scout

Map No. _____ Sec. 23 Twp. 19 R. 12WWell No. 7 Lanterman

Hannum Drlg. _____ Company _____

Contractor _____


NE SE NW

E1.1825
SECTION PLAT

_____ Ft. from N. Line

990 Ft. from S. Line330 Ft. from E. Line

_____ Ft. from W. Line

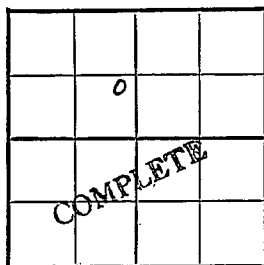

Bartpn

Location _____

Rig up _____

Drilling and Remarks:

8" c 233anhy 650K.C. 3110Comp. 3387arbl 34085" c 3500T.D. 3660

RECORD

Cased _____ in., _____ ft.

Sand _____

Gas _____

Oil _____

Total Depth _____

PRODUCTION

1st 24 hrs. Nat. _____

1st 24 hrs. after shot _____

Gas _____ Cu. Ft.

Dry Hole _____

Abandoned _____

Date

MAY 31 1950

19

J. E. TYRA Scout

24/3405-12 80

250 A

Comp 50 haph

Misc.
Pierce Map
France Map
Tracings
Land Wall Map
Land Small Map
Scout Cards


DATE

BY

REMARKS

RECORD

0550

 

ATTACH

FORM

TABLE

DATE

TIME

LOCATION