


Barton

Section 20 Township 19 Range 11WWell No. #2 Schartz "B"Company Texas

NORTH

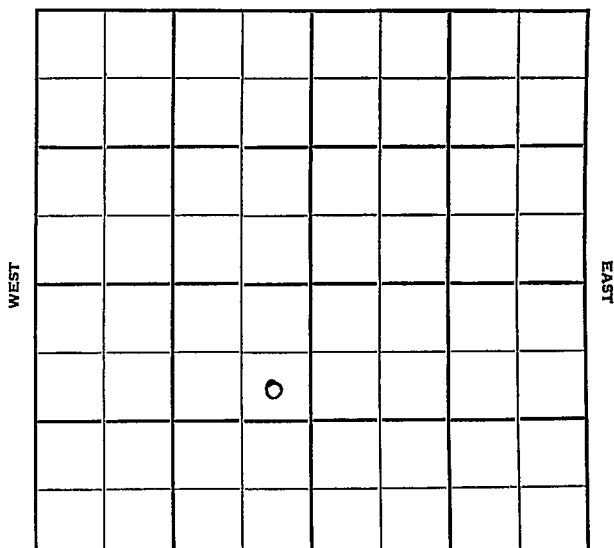

SOUTH

Barton

KANSAS

Sec. 20 Twp. 19 R. 11W

Well No. #2 Schartz "B" Farm

Texas

Company

B & R Drlg.- Contr.

Contractor

Prairie View Pool


990' Ft. from N. Line

Ft. from S. Line

330' Ft. from E. Line

Ft. from W. Line

SE NE SW

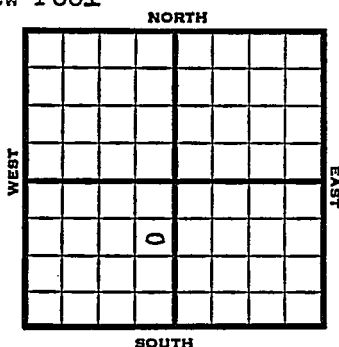

1950

Elv. 1785'

REPORT

1/3  
5/23

RUR

Spd 1-7-51

D&A TD 3394

10" @ 595 Heeb. 2945 Lans. 3082

Cong. 3349 Arb. 3366 TD 3394

7" @ 3370 B/25 gwph SSO SP 3353

40/3318-28 500 A S/5 bo 11 bwph

1000 A S/20 gfph 25% oil SP 3320

12/3302-06 12/3309-12 SP 3312

500 A S/1 bfph 50% oil

72/3248-66 32/3282-90 500 A

S/5 go 35 gw 1 hr. SP 3276

72/3248-62 500 A S/4 bo 1 hr.

S/4 bo 15% wtr ph SP 3236

56/3216-30 1000 A S/2 bfph 15% wtr

DP 3274 1000 A S/22 bo 4 hr

2500 A S/49 bo 138 bw 9 hr. SP 3124

44/3103-14 1000 A S/14½ bo 90 bw

6 hr Perf 3248-66 3216-30

3103-14 DG 3240 S/3 bwph

CO to 3247 3/3235-37 SP 3152

24/3136-42 500 A S/11½ bwph

15/3084-94 1500 A S/5 go 2 gwph

D&A

**ABANDONED**

County Barton State KansasSec. 20 (Blk. Twp.) 19 (Sur. Rge.) 11W Map No.Operator TexasWell No. 2 Farm Schartz <sup>RD</sup>Elev. 1 Location SE NE SW

|  |  |  |  |  |  |  |  |
|--|--|--|--|--|--|--|--|
|  |  |  |  |  |  |  |  |
|  |  |  |  |  |  |  |  |
990 Ft. From N Line SW330 Ft. From E Line Quarter1st. Report JAN 3 1951

Completion


Remarks

B & R Drlg. - Contr.

Spudding Date

Drlg. Data Prairie View PoolRUR

County Barton State Kansas  
 Sec. 20 (Blk. 19) (Sur. 11W) Map No.   
 Operator Texas  
 Well No. 2 Farm Schartz "B"  
 Elev. 1785 Location SE NE SW

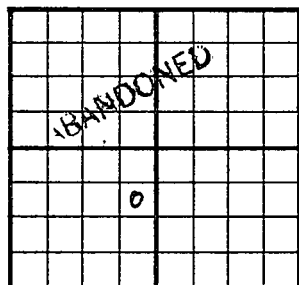990 Ft. From N Line SW330 Ft. From E Line Quarter1st. Report Completion MAY 23 1951Remarks Prairie View PoolB & R Drlg. - Contr.Spudding Date 1-7-51Drlg. Data D & A TD 339410" @ 595 Heeb. 2945 . Lans. 3082Cong. 3349 Arb. 3366 TD 3394 7" @ 3370B/ 25 gwph .SSO SP 3353 40/ 3318-28500 A S/ 5 bo 11 bwph 1000 AS/ 20 gfph 25% oil SP 332012/ 3302-06 12/ 3309-12 SP 3312 500 AS/ 1 bfph 50% oil 72/ 3248-66 32/ 3282-90 500 A S/ 5 go 35 gw 1 hr.SP 3276 72/ 3248-62 500 A S/ 4 bo 1 hr.S/ 4 bo 15% water ph SP 3236 56/ 3216-301000 A S/ 2 bfph 15% water DP 32741000 A S/ 22 bo 4 hr. 2500 AS/ 49 bo 138 bw 9 hr. SP 312444/ 3103-14 1000 A S/ 14<sup>1</sup>/<sub>2</sub> bo 90 bw

J. E. TYRA

Drlg. Data

6 hr. Perf/ 3248-66 3216-30 3103-14  
 DC 3240 S/ 3 bwph CO to 3247 3/ 3235-  
 37 SP 3152 24/ 3136-42 500 A  
 S/  $11\frac{1}{2}$  bwph 15/ 3084-94 1500 A  
 S/ 5 go 2 gwph

D & A

