FORM 51 25M 3-49 PETROL KANSAS


Ellis

Section 3 Township 12 Range 17W

Well No. 5 Miller

Company Westgate-Greenland

Bemis

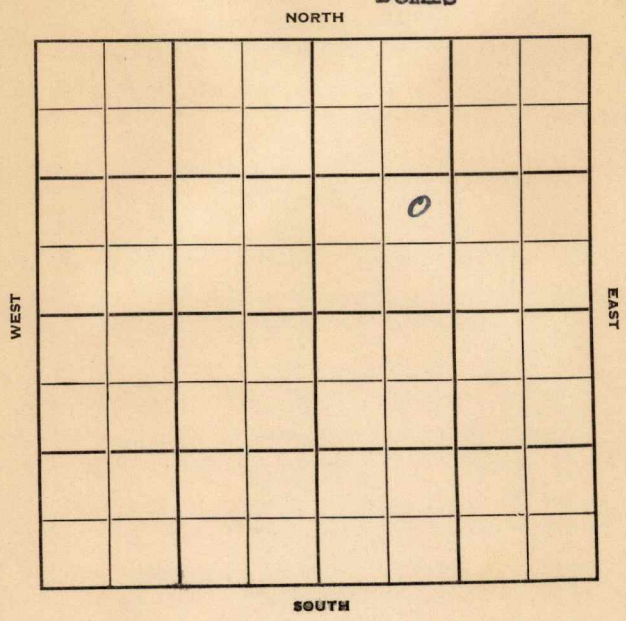

FORM 252-A
5M 10-48 PETROL


Ellis KANSAS

Sec. 3 Twp. 12 R. 17W

Well No. #5 Miller Farm

Westgate-Greenland Company

Bemis Pool (Jacksnn Drlg., Cont.)

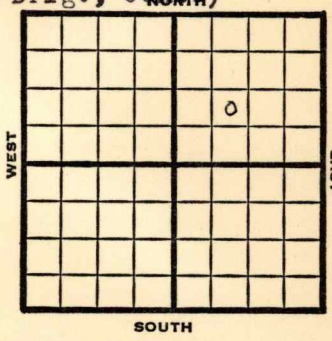

_____ Ft. from N. Line

990' Ft. from S. Line

_____ Ft. from E. Line

990' Ft. from W. Line

NE SW NE

1949	Elev. 2049' REPORT
10/19	8" @ 190' Drlg. 2500'
10/26	Lansing 3278' Simpson 3575' Drlg. 3610'
11/1	Arbuckle 3650' Granite Wash 4030' Granite 4050 TD 4050' 5" @3732'
11/9	"
11/16	"
11/23	"
11/29	"
12/7	"
12/14	"
12/21	"
12/28	"
1950	
1/11	TD 4052½ 8"@ 3732' Salt wtr disposal well Input 100 bbls salt wtr pr hr Aband Anhy 1260' Lan 3278' Cong 3540' Granite wash 4030' Simp 3575' Gr 4050' Arb. 3650' Aband.

ABANDONED

Form 26 200 Bks. 6-49 Petrol
Kansas

Bemis Pool

Map No. _____ Sec. 3 Twp. 12 - R. 17W


Well No. 5 Miller

Westgate-Greenland Company

Jackson Drlg. Contractor

NE SW NE

FIRST REPORT
SECTION PLAT

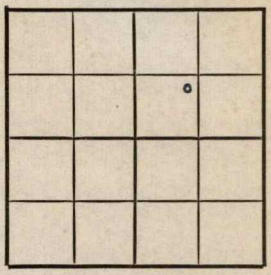

_____ Ft. from N. Line

990 Ft. from S. Line

_____ Ft. from E. Line

990 Ft. from W. Line

Ellis County

Location _____

Rig up _____

Drilling and Remarks:

8" @ 190

drlg. 2500

RECORD

Cased _____ in., _____ ft.

Sand _____

Gas _____

Oil _____

Total Depth _____

PRODUCTION

1st 24 hrs. Nat. _____

1st 24 hrs. after shot _____

Gas _____ Cu. Ft.

Dry Hole _____

Abandoned _____

Date

OCT 19 1949 19 _____

S. J. LEWIS Scout

Form 26 200 Bks. 6-49 Petrol

Kansas

Bemis Pool

Map No. _____ Sec. 3 Twp. 12 R. 17W

Well No. 5 Miller

Westgate-Greenland
Company

Contractor

NE SW NE

E. Elv. 2049

SECTION PLAT



_____ Ft. from N. Line

990 Ft. from S. Line

_____ Ft. from E. Line

990 Ft. from W. Line

Ellis County

Location _____

Rig up _____

Drilling and Remarks:

8" @ 190

5" @ 3732

Salt Water

Disposal Well

Input 100 Bbls

Salt water per hr.

RECORD

Cased _____ in., _____ ft.

Sand _____

Gas _____

Oil _____

Total Depth 4052 1/2

PRODUCTION

1st 24 hrs. Nat. _____

1st 24 hrs. after shot _____

Gas _____ Cu. Ft.

Dry Hole _____

Abandoned _____

Date

JAN 11 1950 19

J. E. TYRA

Scout

Ark 1260
Lan 3278
Cong 3540
Simp 3575
Ark 3650
Granite Wash 4030
Gr. 4050

JAN 16 1950

Scout Cards Seath
Land Small Map
Land Wall Map 5
Tracings
France Map
Pierce Map
Misc.