
FORM 51 25M 8-50 WESTERN

Barton KANSAS

Section 25 Township 19 Range 12W

Well No. #2 Brodie

Company W.L. Hartman

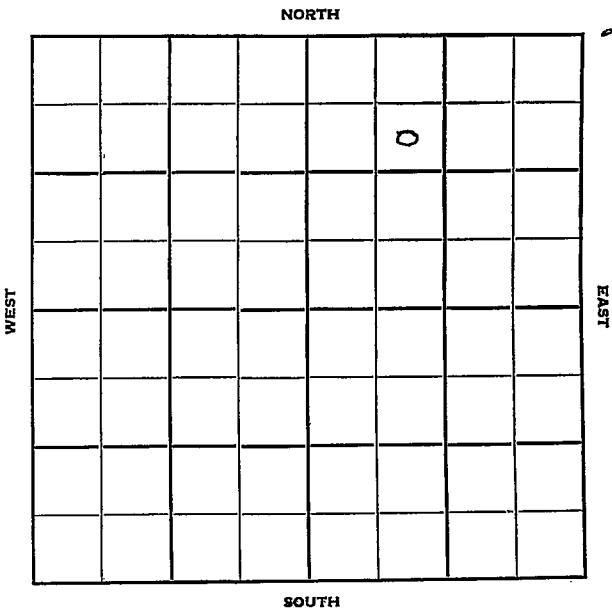

FORM 252-B
10M 10-50 PETROL

Barton KANSAS

Sec. 25 Twp. 19 R. 12 W

Well No. # 2 Brodie Farm

W. L. Hartman Company

Contractor

Werner-Robl


990 Ft. from N. Line

Ft. from S. Line

Ft. from E. Line

990 Ft. from W. Line

SE NW NE

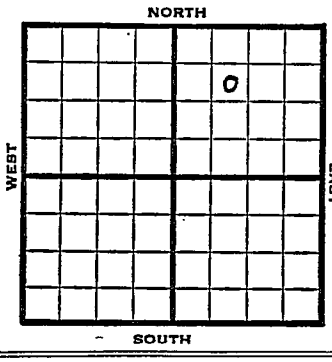

1952 Elev. 1800' REPORT

1/9 RUR
2/6 TD 3368'
5" @ 3366' POP

2/13 No report
2/20 "

3/5 NR
3/11 "

3/19 Spud 1-8-52
Oil Well TD 3368
8" @ 160 Top. 2684
DST 2878-2900 Rec. 270' hocm
Hèeb. 2940 Br Lime 3056
Lans. 3072
DST 3073-85 opn 1 hr. Rec. 100' o&gcm 20' free oil
DST 3092-3103 opn 1 hr. Rec. 10' mud
DST 3111-38 opn ½hr.
Rec. 120' o&gcm 240' oil
DST 3139-51 opn 11 min. Rec. 315' oil DST 3158-76 opn 1 hr. Rec. 30' mud DST 3205-17 opn ½ hr.
Rec. 120' mco 300' free oil
DST 3238-48 opn 1 hr. Rec. 30' socm
DST 3262-70 opn 1 hr. Rec. 20' mud
DST 3289-95 opn ½ hr. Rec. 15' mud
Arb. 3365-68 5"@ 3366 CO to 3367
FU 425' oil 12 hr. Comp. 302 bopd

COMPLETED

FORM 275 FOR SALE BY KANSAS BLUE PRINT CO.


County Barton State Kansas

Sec. 25 (Blk. Twp.) 19 (Sur. Rge.) 12W Map No.

Operator W. L. Hartman

Well No. 2 Farm Brodie

Elev. Location SE NW NE

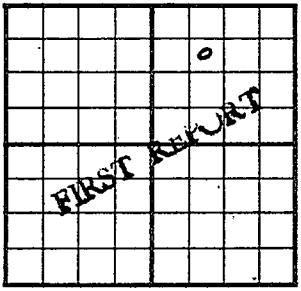

990 Ft. From N Line NE

990 Ft. From W Line Quarter

1st. Report JAN 9 1952

Completion

Remarks

Spudding Date

Drlg. Data Werner - Robl

RUR

J. E. TYRA

FORM 275 FOR SALE BY KANSAS BLUE PRINT CO.


County Barton State Kansas

Sec. 25 (Blk. Twp.) 19 (Sur. Rge.) 12W Map No.

Operator W. L. Hartman

Well No. 2 Farm Brodie

Elev. 1800 Location SE NW NE

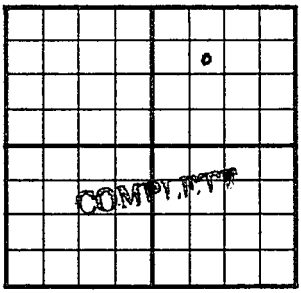

990 Ft. From N Line NE

990 Ft. From W Line Quarter

1st. Report

Completion MAR 1 9 1952

Remarks Werner-Robl Pool

Spudding Date 1-8-52

Drlg. Data Oil well TD 3368

8" @ 160 Top. 2684 DST 2878-2900

~~Rec. 270' hocm Heeb. 2940~~

Br. lime 3056 Lans. 3072 DST 3073-85

open 1 hr. Rec. 100' o & gcm 20' free

oil DST 3092-3103 open 1 hr. Rec.

10' mud DST 3111-38 open ½ hr.

Rec. 120' o & gcm 240' oil DST 3139-51

open 11 min. Rec. 315' oil DST 3158-

76 open 1 hr. Rec. 30' mud DST 3205-

17 open ½ hr. Rec. 120' mco 300' free

oil DST 3238-48 open 1 hr. Rec.

30' socm DST 3262-70 open 1 hr.

Rec. 20' mud DST 3289-95 open ½ hr.

Rec. 15' mud Arb. 3365-68 5" @ 3366

J. G. McGEHEE

Drlg. Data

CO to 3367 FU 425' oil 12 hr.

Comp. 302 bopd

