

KANSAS

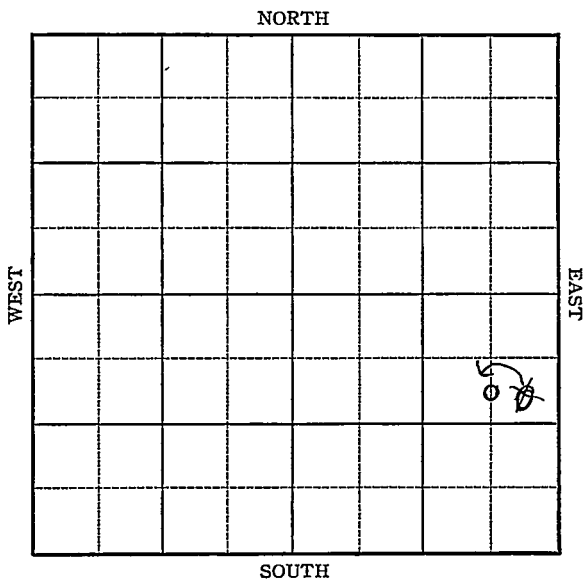
Russell

FORM 51 5M 1-42 PETROL

Section 31 Township 14 Range 12-W

Well No. #1 Bekarek

Company Skelly

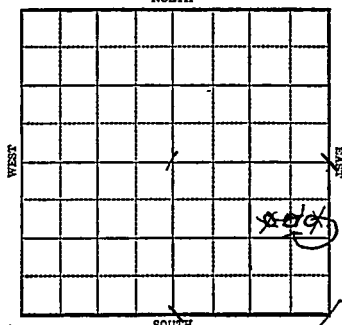


KANSAS

Russell

Sec. 31 Twp. 14 R. 12-WWell No. #1 Bekarek FarmSkelly Company

NORTH

990 Ft. from N. Line Ft. from S. Line~~330~~ 660~~390~~ Ft. from E. Line Ft. from W. LineElev. 1740 - 1736

1943

R E P O R T

5/19	Location
5/26	"
6/2	"
6/9	"
6/16	Derrick
6/23	"
6/30	Anhy 685' Run Csg.
7/7	10" @ 686' Drig. 870'
7/15	Drig. 2665'
7/21	Lans 2893 Arb 3185 T.D. 3187 5" @ 3185' RUST
7/28	"
8/4	Pump 153 oil in 9 hrs.
8/11	" " " " "
8/18	500 acid pump 295 oil in 20 hrs
8/25	" " " " "

OVER

1943

9/1

Arb 3185

6" @ 3185

500 acid

Echo Pot. 1386

T.D. 3187

Gravity 40

COMPLETED

Rus se 11

KANSAS

Map No. 56 Sec. 31 Twp. 14 R. 12WWell No. 1 BekarekSkelly

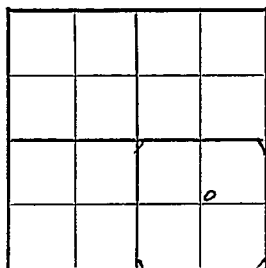
Company

FIRST REPORT

Contractor

SW NE SE

SECTION PLAT

990 Ft. from N. Line Ft. from S. Line990 Ft. from E. Line Ft. from W. Line

GREENVALE POOL

Location XXXRig up

Drilling and Remarks:

RECORD

Cased in., ft.Sand Gas Oil Total Depth

PRODUCTION

1st 24 hrs. Nat. 1st 24 hrs. after shot Gas Cu. Ft.Dry Hole Abandoned

Date

MAY 1 9 1943

19

S. J. LEWIS : Scout

KANSAS

Russell

Map No. 56 Sec. 31 Twp. 14 R. 12WWell No. 1 Bekarek

Skelly

Company

CORRECTION

Contractor

SE NE SE

990 Ft. from N. Line

Ft. from S. Line

330 Ft. from E. Line

Ft. from W. Line

SECTION PLAT

			a

GREENVALE POOL

Location

Rig up

Drilling and Remarks:

Reported

SW NE SE

RECORD

Cased _____ in., _____ ft.

Sand _____

Gas _____

Oil _____

Total Depth _____

PRODUCTION

1st 24 hrs. Nat. _____

1st 24 hrs. after shot _____

Gas _____ Cu. Ft.

Dry Hole _____

Abandoned _____

Date

MAY 22 1943

19

S. J. LEWIS

Scout

KANSAS

Map No. 36 Sec. 31 Twp. 14 R. 12WWell No. 1 BekarekSkelly

Company

CORRECTION

Contractor

C SL NE SE

990 Ft. from N. Line Ft. from S. Line1660 Ft. from E. Line Ft. from W. Line

GREENVALE POOL

SECTION PLAT

			o

Location

Rig up

Drilling and Remarks:

Skelly Changed

the location again

from SE NE SE

RECORD

Cased in., ft.Sand Gas Oil Total Depth

PRODUCTION

1st 24 hrs. Nat. 1st 24 hrs. after shot Gas Cu. Ft.Dry Hole Abandoned

Date

JUN 9 1943 19S. J. LEWIS Scout

KANSAS

Map No. 56 Sec. 31 Twp. 14 R. 12WWell No. 1 BekarekSkelly CompanyCOMPLETED Contractor

C S L NE SE

990 Ft. from N. Line Ft. from S. Line660 Ft. from E. Line Ft. from W. Line

Greenville Pool

SECTION PLAT

			o

Location Rig up

Drilling and Remarks:

Cr 8/85
1" @ 8/85.
500 acid
Ech 8/85

40 2 Gr

RECORD

Cased in., ft.Sand Gas Oil Total Depth 8/87

PRODUCTION

1st 24 hrs. Nat. 1st 24 hrs. after shot Gas Cu. Ft.Dry Hole Abandoned

Date

SEP 1 1943 19 S. J. LEWIS Scout