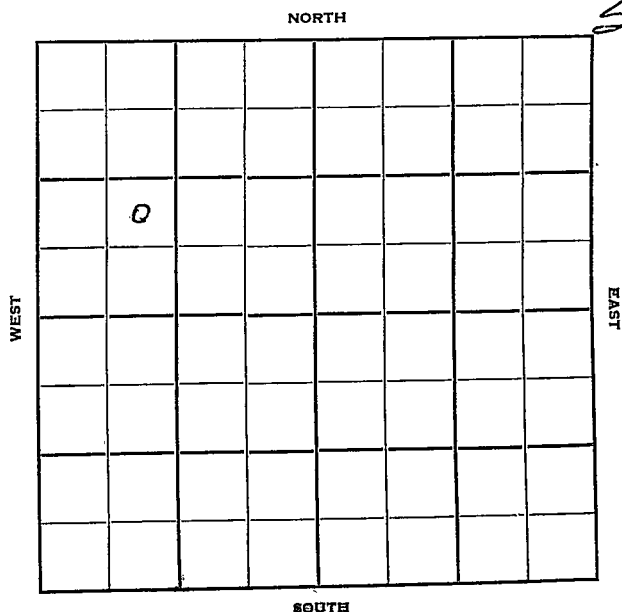


Section 12 Township 19 Range ~~21W~~Well No. #3 KultgenCompany Alad in Pet.

KANSAS

Barton

Sec. 12 Twp. 19 R. 12-W

Well No. #3 Kulgen Farm

Aladdin & Grow

Company

Cheyenne View


NORTH

 Ft. from N. Line

990 Ft. from S. Line

 Ft. from E. Line

990 Ft. from W. Line

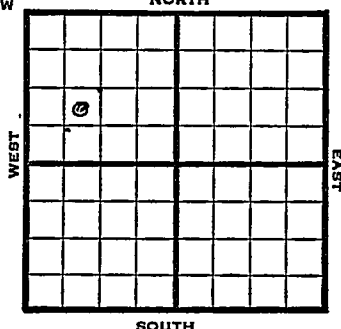

NE SW NW

1950

Elev 1797' REPORT

2/22

Spud 2-18-50

8" @ 210'

Anhy 600

3/22

Drlg 1580'

8" @ 210'

Anhy 660

DST 2879-2900

Rec 90' oil cut mud

Lans 3074'

DST 3076-3146'

Cong 3345'

Arb. 3380-85' TD

TD 3385'

5" @ 3384'

24 shots 3307-15

24 shots 3298-94

24 shots 3280-88'

24 shots 3268-76'

Set Plug 3261

24 shots 3245-53

6 shots 3235-37'

18 shots 3222-28

48 shots 3200-16'

SO 3235-37

SSO 3222-28

Bail 4 BOPH

1500 acid

Flowed 216 BO 2 hrs.

65 BOPH 1" choke

Comp 1609 BOPD

Comp

COMPLETED


Map No. _____ Sec. 12 Twp. 19 R. 12WWell No. 3 KultgenAladdin & Crow

Company

Contractor

NE SW NW

SECTION PLAT

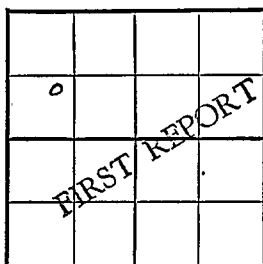

_____ Ft. from N. Line

990 Ft. from S. Line

_____ Ft. from E. Line

990 Ft. from W. Line

Barton County

Location _____

Rig up _____

Drilling and Remarks:

Spud 2-18-50

8" @ 210

Anhy 600

drlg. 1580

RECORD

Cased _____ in., _____ ft.

Sand _____

Gas _____

Oil _____

Total Depth _____

PRODUCTION

1st 24 hrs. Nat. _____

1st 24 hrs. after shot _____

Gas _____ Cu. Ft.

Dry Hole _____

Abandoned _____

Date

FEB 22 1950 19

J. E. TYRA


Scout

Map No. _____ Sec. 12 Twp. 19 R. 12WWell No. 3 KultgenAladdin & Crow

Company

Contractor

NE SW NW

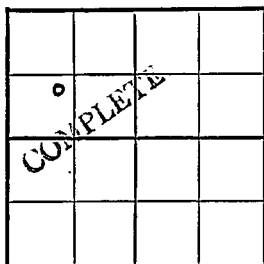E1. 1797
SECTION PLAT

Ft. from N. Line

990

Ft. from S. Line

Ft. from E. Line

990

Ft. from W. Line

Barton County

Location _____

Rig up _____

Drilling and Remarks:

RECORD

Cased _____ in., _____ ft.

Sand _____

Gas _____

Oil _____

Total Depth _____

PRODUCTION

1st 24 hrs. Nat. _____

1st 24 hrs. after shot _____

Gas _____ Cu. Ft.

Dry Hole _____

Abandoned _____

8" C 210
 anhy 660
 DST 2877-2900
 Rec. 90' oil cut mud
 Lane. 3074
 DST 3076-3146
 Rec. Cong. 3345
 Arb. 3380-8570
 5" C 3384

Date

MAR 22 195019J. E. TYRA

Scout

24 shots 3307-15

24 " 3298-94

24 " 3280-88

24 " 3268-76

Set plug 3261

24 shots 3245-53

6 " 3235-37

18 " 3222-28

48 " 3200-16

50 3235-37

550 3222-28

Bail 4 baph

1500 acid

Flowed 216 ls 2 hrs.

" 65 baph 1" choke

Comp. 1609 baph

SECTION PLAT

Contractor

Company

Well No.

Well No.