
KANSAS

FORM 51 25M 3-49 PETROL

Section 18 Township 19 Range 11-W

Well No. #1 F. Robl

Company ~~E. H. Adair~~

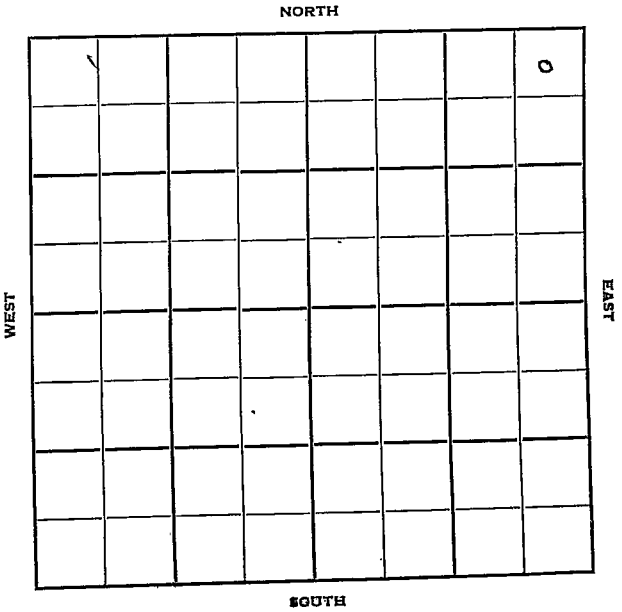

FORM 252-B
10M 9-49 PETROL

KANSAS Barton

Sec. 18 Twp. 19 R. 11-W

Well No. #1 F. Robl Farm

E. H. Adair Company

Contractor


330 Ft. from N. Line

Ft. from S. Line

330 Ft. from E. Line

Ft. from W. Line

NE NE NE

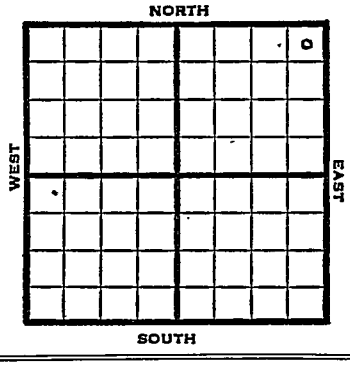

1950

Elev 1775

REPORT

5/17 Spud 5-15-50
Drlg 101'

6/28 TD 3380
8" @ 229
Anhy 572 Topeka 2666
Heeb 2930 Br lime 3047
Lans 3063
DST 3065-96, rec 70' ocm
Cong 3337
5" @ 3380
24/3084-92
150' oil
1000 acid
F/40 boph
Comp 476 bopd
Completed

COMPLETED

Form 26 200 Bks. 11-49 Petrol

Kansas

Map No. _____ Sec. 18 Twp. 19 R. 11W

Well No. 1 F. Robl

E. H. Adair Company

Contractor

NE NE NE


330 Ft. from N. Line

_____ Ft. from S. Line

330 Ft. from E. Line

_____ Ft. from W. Line

SECTION PLAT

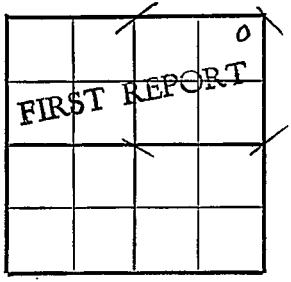

Barton

Location

Rig up

Drilling and Remarks:

Spud 5-15-50

Drlg 101

RECORD

Cased _____ in., _____ ft.

Sand

Gas

Oil

Total Depth

PRODUCTION

1st 24 hrs. Nat.

1st 24 hrs. after shot

Gas _____ Cu. Ft.

Dry Hole

Abandoned

Date

MAY 17 1950

19

J. E. TYRA Scout

Form 26 200 Bks. 11-49 Petrol

Kansas

Map No. ____ Sec. 18 Twp. 19 R. 11W

Well No. 1 F. Robl


E. H. Adair Company

Contractor

NE NE NE

El. 1775

SECTION PLAT

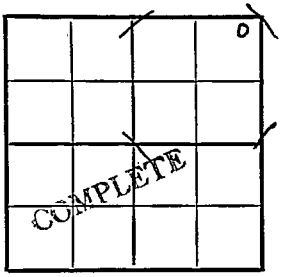

330 Ft. from N. Line

Ft. from S. Line

330 Ft. from E. Line

Ft. from W. Line

Barton County

Location

Rig up

Drilling and Remarks:

8" C 229
Anhy 572
Topeka 2666
Heeb. 2930
Br. lime 3047
Lans. 3063
DST 3065-96

RECORD

Cased ____ in., ____ ft.
Sand
Gas
Oil
Total Depth 3380

PRODUCTION

1st 24 hrs. Nat.
1st 24 hrs. after shot
Gas Cu. Ft.
Dry Hole
Abandoned

Rec. 70' ocm

Date

JUN 28 1950 19

J. E. TYRA Scout

Cong. 3337

5" @ 3380

TD 3380

24/ 3084-92

150' oil

1066 acid

F/ 40 boph

Comp. 476 bopd

JUL 3 1950

Scout Cards

Land Small Map

Land Wall Map

Tracings

France Map

Pierce Map

Misc.