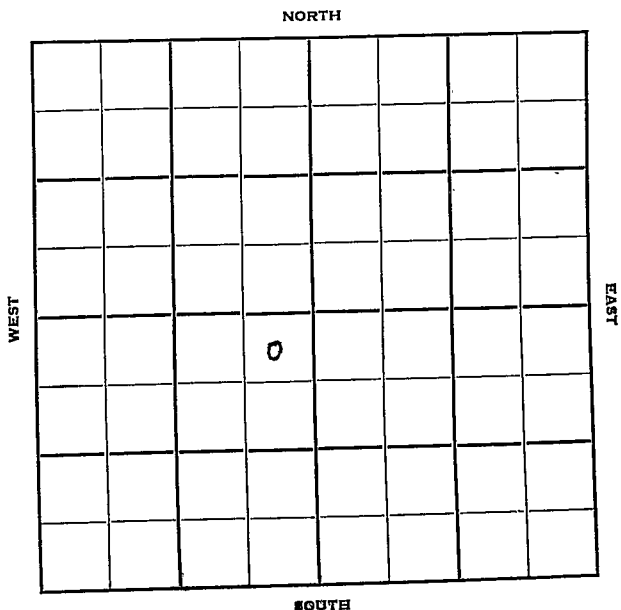


Barton

KANSAS

Section 20 Township 19 Range 11WWell No. #1 SchartzCompany Texas

KANSAS

Barton

Sec. 20 Twp. 19 R. 11-W

Well No. #1 Schartz Farm

Texas Company

Powell & Peters Contractor

Prairie View


330 Ft. from N. Line

 Ft. from S. Line

330 Ft. from E. Line

 Ft. from W. Line

NE NE SW

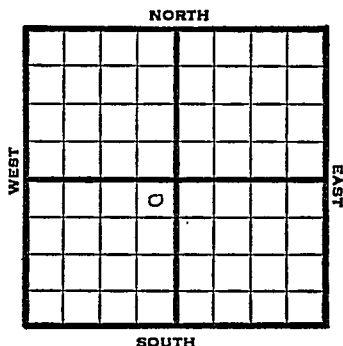

1950	Elev 1786	REPORT
9/13	Spud 9-8-50 10 3/4" @ 597 drlg 1800	
11/1	10 3/4" @ 597 Heeb 2942 Lans 3076 DST 3061-97 opn 1 hr rec 150' gas 75' o&gem DST 3157-70 opn 1 hr 15 min rec 150' SW DST 3218-23 opn 45 min rec 120' ho & gem 50% oil TD 3250 DST 3242-50 opn 45 min rec 5" drlg mud DST 3307-24 opn 1 1/4 hr rec 120' hocm 90% oil TD 3387 7" @ 3376 DD 3403 S/3 1/2 BW Cong 3347 DD 3406 S/10 bwph SP 3356 48/3291-3306, 20/3311-16 500 A S/15 1/2 boph SP 3290, 36/3276-85 500 A S/18 1/2 bo SSW SP 3270 60/3240-46 500 A	Br lime 3060 Arb 3379

OVER

1950

11/1 S/53 bo SSW

SP 3226

32/3212-20 500 A

S/17 $\frac{1}{2}$ boph SP 3126

16/3060-64

16/3088-92, 12/3117-20


B/10 fw 2000 A

S/1 bo 1 gwph S/236 bo 3 hr .

Comp 465 bopd 5% wtr

Completed

COMPLETED

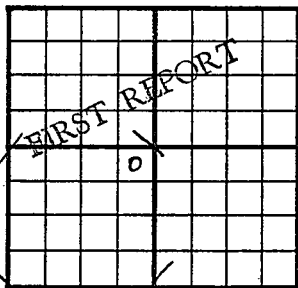County Barton State KansasSec. 20 (Blk. Twp.) 19 (Sur. Rge.) 11W Map No.Operator TexasWell No. 1 Farm SchartzElev. 1786 Location NE NE SW330 Ft. From N Line SW330 Ft. From E Line Quarter1st. Report SEP 13 1950


Completion

Remarks

Spudding Date 9-8-50Drlg. Data Prairie View Pool10 3/4" @ 597 drlg. 1800

J. E. TYRA

County Barton State Kansas
 Sec. 20 (Blk. 19 (Sur. 11W Map No.)
 Twp.) (Rge.)
 Operator Texas
 Well No. 1 Farm Schartz
 Elev. 1786 Location NE NE SW

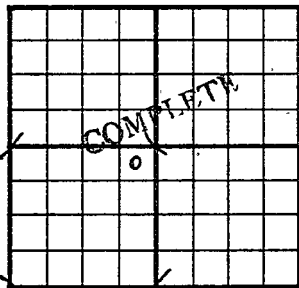

330 Ft. From N Line SW

330 Ft. From E Line Quarter

1st. Report

Completion NOV 1 1950

Remarks Prairie View Pool

Powell & Peters - Contr.

Spudding Date 9-8-50

Drlg. Data Oil well TD 3406
10 3/4" @ 597 Heeb. 2942 Br. lime 3060
Lens. 3076 DST 3061-97 open 1 hr.
Rec. 150' gas 75' o & gcm DST 3157-70
open 1 hr. 15 min. Rec. 150' sw
DST 3218-23 open 45 min. Rec. 120' ho &
gcm 50% oil TD 3250 DST 3242-50
~~open~~ open 45 min. Rec. 5" drlg. mud DST 3307-
24 open 1 1/4 hr. Rec. 120' hocm 90% oil
TD 3387 7" @ 3376 DD 3403 S/ 3 1/2 bw
Cong. 3347 Arb. 3379 DD 3406
S/ 10 bwph SP 3356 48/ 3291-3306
20/ 3311-16 500 A S/ 15 1/2 boph SP 3290
36/ 3276-85 500 A S/ 184 1/2 bo SSW
SP 3270 60/ 3240-46 500 A

J. E. TYRA

Drig. Data

S/ 53 bo SSW SP 3226 32/ 3212-20

500 A S/ 17 $\frac{1}{2}$ bopd SP 3126 16/ 3060-64

16/ 3088-92 12/ 3117-20 B/ 10 gw 2000 A

S/ 1 bo 1 gwph S/ 236 bo 3 hr.

Comp. 465 bopd 5% water

NOV 7 1960

Scout Cards
Land Small Map
Land Wall Map
Tracing
France 1-10
Pierce Map
Misc.