Russell


KANSAS

SECTION 16 TOWNSHIP 15S RANGE 13W

WELL NO. #5 Bitter

COMPANY CRA

NORTH S/2 N/2 NW

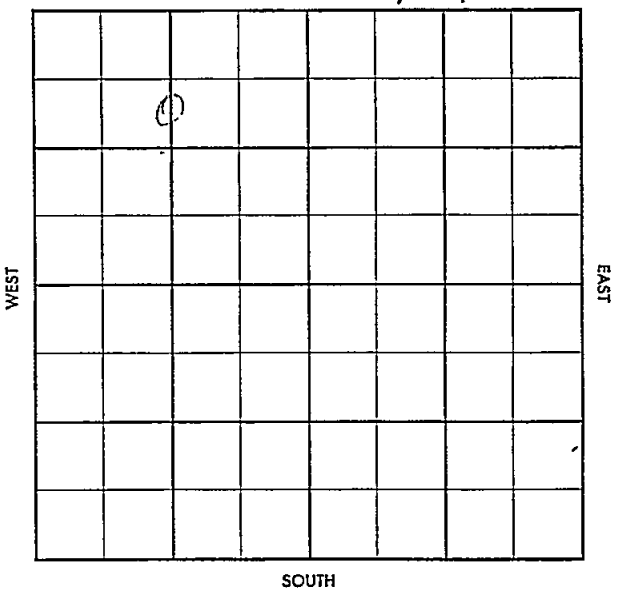

FORM 504-3 SUNRAY

Twp. Pool

Co. Pool

S-513-B

Co.

County Russell Elev.

Sec. 16 Twp. 15 Rge. 13W

Company C R A

Farm Name Bitter No. 5

TOPS	DEPTH	LOG	DATUM
Anh.			
Tp.			
H.			
Tr.			
Dg.			
B. L.			
L.			
K.C.			
B.K.C.			
Ce.			
C.			
M.			
M.			
K.			
Mz.			
Mq.			
V.			
S.			
S.			
A.			
R.			
Pf.			
G.			
T.D.			

Loc. in Sec. S½ N½ NW

Geol.

Contr.

Pool

JUN 18 58

FIRST REPORT

Date Comm. 6-13-58

drlg. 665

Sec.

T.

R.

Twp. X Pool

Co. X Facet

S-513-B

County Russell Elev 1881DF 1884KB

Sec. 16 Twp. 15 Rge. 13W

Company C R A

Farm Name Bitter No. 5

TOPS	DEPTH	LOG	DATUM
Anh. Dover	2420		
Tp. Tarkio	2466		
H. TP	2742		
Tr. Deer Creek	2829		
Dg Lecomp	2852		
B. L. Plattsmouth	2893		
L. H	2973		
K.C. TR	2990		
B.K.C. LSG	3043		
Ce.			
C.			
M.			
M.			
K.			
Mz.			
Mq.			
V.			
S.			
S.			
A.	3320		
R.			
Pf.			
G.			
T.D.	3326		

Loc. in Sec. S½ N½ NW

Geol.

Contr.

Pool Trapp

JUL 9 '58
COMPLETE

Date Comm. 6-13-58 8" 860/425

drlg. 665 JUN 25 '58 5½ 3324/180 JUL 2 '58

to 3326 TD FU 600' oil 1hr

B2BO NW NT Lo+s gas FU 1998

Oil NW NT pop P85BO NW

24hrs JUL 9 '58 P96BO 3BW 24hrs

Co. Lse. No. Sec. T. R.