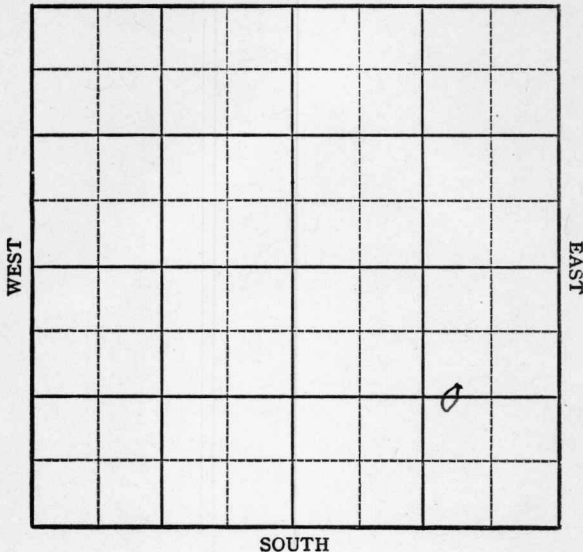


Section 7 Township 15 Range 13WWell No. 7 JosephineCompany Carter *del*Trapp Pool
NORTH

KANSAS

Russell

Sec. 7 Twp. 15 R. 13W ✓

Well No. #7 Josephine Farm

Carter

Company

Trapp Pool


1320' Ft. from N. Line

Ft. from S. Line

990' Ft. from E. Line

Ft. from W. Line

C W L E $\frac{1}{2}$ SE

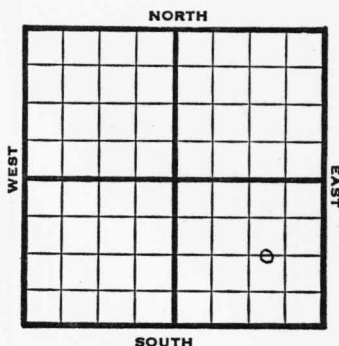

1948

Eli 1796'

R E P O R T

1948

Location

9/14

10"@ 385'

9/21

Lansing 2966'

Drlg 3070'

9/ 29

Arb. 3240-43'

TD 3243'

7"@ 3241'

10/6

PB 3086-23 shots 3003-09' 3000 acid
swb 25 bbls oil / 24 W 6 hrs.

10/13

12 shots 3000-03

33 shots 2984-92'

10/19

"

10/26

TD 3243'

Lansing 2966'

Arb. 3240'

7"@ 3241'

Perf Lans. 3000 acid

Pump 156 Oil / 6% W Pot

40⁹ Gr.

Comp

COMPLETED

Russell County Kansas State
 Map No. _____ Sec. 7 Twp. 15 R. 13W

Well No. 7 Josephine


Carter Company

FIRST REPORT

Contractor _____

C W L E $\frac{1}{2}$ SE

SECTION PLAT

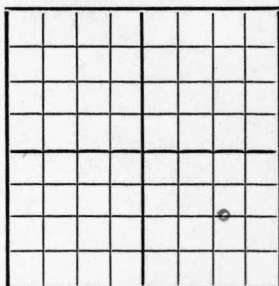

1320 Ft. from N. Line

_____ Ft. from S. Line


990 Ft. from E. Line

_____ Ft. from W. Line

Trapp Pool

Remarks: _____

Location

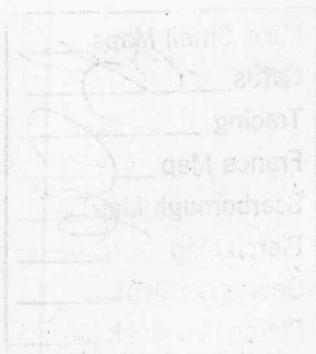

Date SEP 8 1948

Scout S. J. LEWIS

Kansas

Trapp Pool


Map No. 73 Sec. 7 Twp. 15 R. 13WWell No. 7 JosephineCarter Company

COMPLETE

Contractor

C W L E $\frac{1}{2}$ SEE 1.1796
SECTION PLAT1320 Ft. from N. Line Ft. from S. Line990 Ft. from E. Line Ft. from W. Line

Russell County

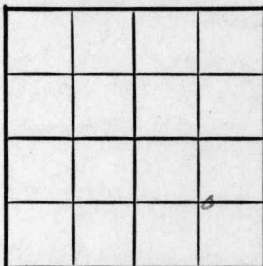Location Rig up

Drilling and Remarks:

Line 2966Cr Y32407" @ 3241Ref Linesoo acidPrux 15611 +673N pot

RECORD

Cased in., ft.Sand Gas Oil Total Depth 3241

PRODUCTION

1st 24 hrs. Nat. 1st 24 hrs. after shot Gas Cu. Ft.Dry Hole Abandoned 40 1/2

7 1948

19

S. J. LEWIS

Scout

CO. ~~Russell~~ ELEV. 1796
 SEC. ~~7~~ TWP. ~~15~~ RGE. 13W
 COMPANY Carter Oil NO. 7

COMPLETE

NOV 27 '57

FARM D. Josephine

(O.W.W.O.)

LOC. C W/2 E/2 SE

O.W.W.O.

GEOL.

CONTR.

POOL Trapp

SPUD

Old Info. Lans. 2966

Arb 3240, OTD 3243

7" @ 3241 was lans. prod.

NEW INFO RAN S.L. measure-
ment TD should be 3247, CC

3247 TD, Swb 2.9 BO + 23

BWPH - 1st 2 hrs, 2nd 4 hrs, Swb 4.3

+ 24 bwph ran tbg - To POP Note:

a packer has been set to "block" Lans
perfs. NOV 30 '57 NOV 6 '57 NOV 13 '57P 7B0 pd + 465 Bwph PB
3174 3 1/4 3156 - 60 1/4 3060 - 64

NOV 20 '57 2500A 3156 - 60 1/4

1B fld ph 3090 oil 3 hrs
1500A 3060 - 64 1B fld ph
5090 D 5 hrs POP

NOV 27 '57 P 29A0 + 36 Bwph

LKC 3060 - 64

3158 - 62

CO

LSE

NO

SEC

CC

TWP

RGE

13
O.W.W.O.

S-513-A

CO. Russell ELEV. 1796
SEC. 7 TWP. 15 RGE. 13W
COMPANY Carter Oil NO. 7

FIRST REPORT			
OCT 23 1977			

FARM D. Josephine

(O.W.W.O.)

LOC. C W/2 E/2 SE

O.W.W.O.

GEOL. _____

CONTR. _____

POOL Trapp

SPUD Old Info. Lans.

2966, Arb 3240, OTD 3243

7" @ 3241 was Lans. prod.

New Info. ran S.L.

measurement TD should be

3247, CO 3247 TD, Swb

2.9 BO *+ 23 BWPH - 1st

2 hrs, 2nd 4 hrs, Swb 4.3 BO + 24 bwph

ran tbg - To POP Note: a packer has been

set to "block" Lans perfs.

CO.

LSE.

NO.

SEC.

TWP.

RGE.