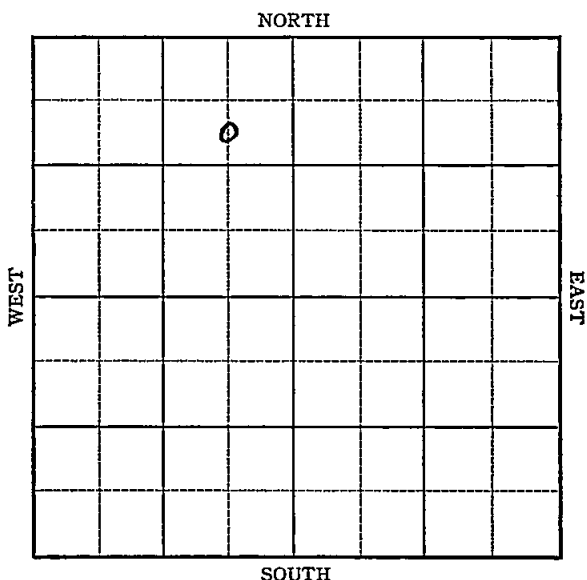
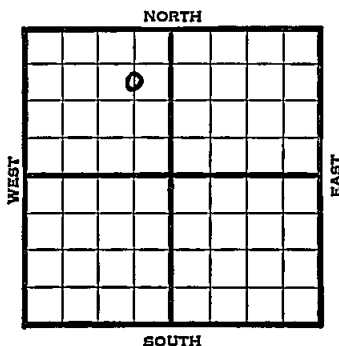


Russell

KANSAS

Section 16 Township 15 Range 13WWell No. 4 - BitterCompany Coralena

[illegible]

Map No. 72 Sec. 16 Twp. 15 R. 13WWell No. 4 BitterCoralena

Company

Contractor

## FIRST REPORT

C S L NE NW

990 Ft. from N. Line       Ft. from S. Line660 Ft. from E. Line       Ft. from W. Line

CORALENA POOL

## SECTION PLAT

|  |   |  |  |
|--|---|--|--|
|  |   |  |  |
|  | o |  |  |
|  |   |  |  |
|  |   |  |  |
|  |   |  |  |
|  |   |  |  |

Location                     Rig up                     Drilling and Remarks:       10" - 200WOC

## RECORD

Cased            in.,            ft.Sand                     Gas                     Oil                     Total Depth                     

## PRODUCTION

1st 24 hrs.-Nat.                     1st 24 hrs. after shot                     Gas            Cu. Ft.Dry Hole                     Abandoned                     

Date

JUN 11 1941S. J. LEWIS Scout

Map No. \_\_\_\_\_ Sec. 16 Twp. 15 R. 13WWell No. 4 BitterCoralena

Company \_\_\_\_\_

Contractor \_\_\_\_\_

COMPLETED

## SECTION PLAT

C S L NE NW

990 Ft. from N. Line

\_\_\_\_\_ Ft. from S. Line

660 Ft. from E. Line

\_\_\_\_\_ Ft. from W. Line

CORALENA POOL

|  |   |  |  |
|--|---|--|--|
|  |   |  |  |
|  | o |  |  |
|  |   |  |  |
|  |   |  |  |
|  |   |  |  |

Location \_\_\_\_\_

Rig up \_\_\_\_\_

Drilling and Remarks:

*have 3054**5" @ 3082**1000 Acid**Pump. 129 1/2 ft.**352 Gr*

## RECORD

Cased \_\_\_\_\_ in., \_\_\_\_\_ ft.

Sand \_\_\_\_\_

Gas \_\_\_\_\_

Oil \_\_\_\_\_

Total Depth 3104

## PRODUCTION

1st 24 hrs. Nat. \_\_\_\_\_

1st 24 hrs. after shot \_\_\_\_\_

Gas \_\_\_\_\_ Cu. Ft.

Dry Hole \_\_\_\_\_

Abandoned \_\_\_\_\_

Date

JUN 25 1941 19S. J. LEWIS

Scout