


Section 2 Township 15 Range 14W

Well No. #10 Michel (A)

Company National Cooperative Ref. Assn.

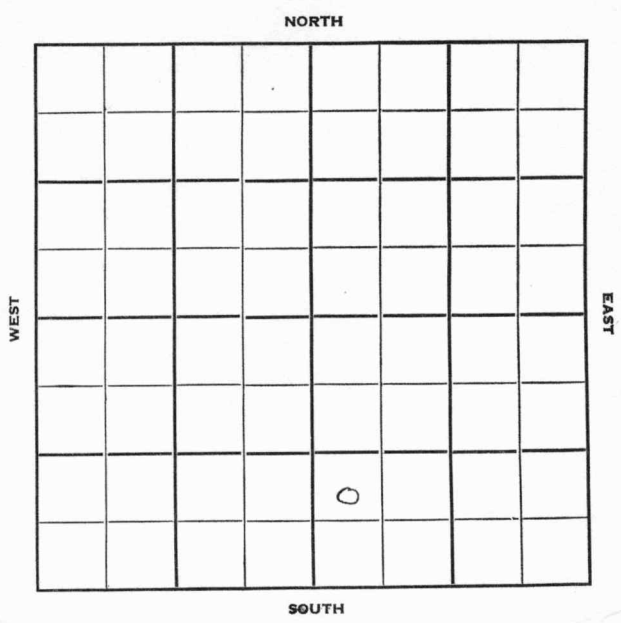

Russell

O. W. D. D
KANSAS

Sec. 2 Twp. 15 R. 14W

Well No. #10 Michel (A) Farm ☒

National Cooperative Ref. Assn. Company

Contractor


 Ft. from N. Line

990' Ft. from S. Line

 Ft. from E. Line

330' Ft. from W. Line

NW SW SE

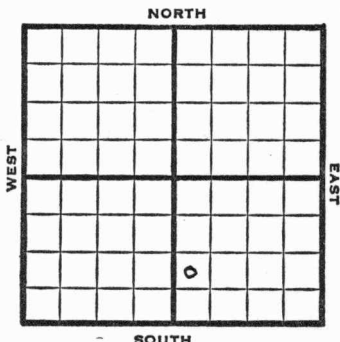

1951

Elev. 1734'

REPORT

10/17 Location

11/14 Spud 10-21-51
10" @ 745' TD 2075' D & A

ABANDONED

11/21 Drlg. 2150'
8" @ 2136'

O. W. D. D

1952

1/2 Oil Well TD 2317
8" @ 2136
Tar. 2309
7" @ 2309 TD 2317
B/ 15 GOPH Hydrafrac
S/ 80 BO 8 hr. S/ 8 BOPH
9 hr.
Comp. 70 BOPD

COMPLETED

County **Russell** State **Kansas**
Sec. **2** (Blk.) **15** (Sur.) **14W** Map No.
(Twp.) (Rge.)
Operator **National Cooperative Ref. Assn.**
Well No. **10** Farm **Michel (A)**
Elev. Location **NW SW SE**

FIRST REPORT

O

990 Ft. From **S** Line **SE**
330 Ft. From **W** Line Quarter

1st. Report **OCT 17 1951**

Completion

Remarks


Spudding Date

Drlg. Data

Location

J. E. TYRA

County Russell State Kansas
 Sec. 2 (Blk. 15) (Sur. 14W) Map No.
 Operator National Coop Ref. Assn,
 Well No. 10 Farm Michael "A"
 Elev. 1734 Location NW SW SE

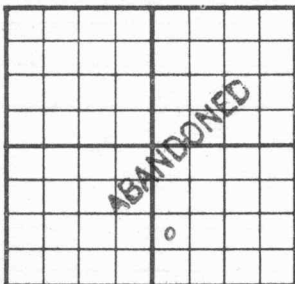

990 Ft. From S Line SE
330 Ft. From W Line Quarter

Ist. Report

Completion NOV 14 1951

Remarks

Spudding Date 10-21-51

Drlg. Data

10" @ 745 TD 2075

D & A

J. E. TYRA

J. E. TYRA

Kansas

State

Russell

County

Map No.

(Surf.) 14W (Rge.)

(Blk.) 15

2

Sec.

N C R A

Operator

10 Farm

Well No.

Michael "A"

NW SW SE

Location

Elev.

N Line SE

990 Ft. From

W Line

330 Ft. From

Quarter

1st. Report NOV 21 1951

Completion


Remarks

Spudding Date

Drig. Data

8" @ 2136

dr16. 2150

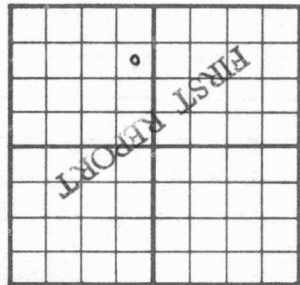

J. E. TYRA

County

Russell

State, Kansas

Sec.

2

(Bk.)

15

(Sur.) 14W

Map No.

Operator

N C R A

Well No.

10

Farm

Michael "A"

Elev.

1734

Location

NW SW SE

990 Ft. From

N Line

SE

330 Ft. From

W Line

Quarter

1st. Report

JAN 2 1952

Completion

Remarks

Spudding Date

TD 2317

Drig. Data

Oil well

8" @ 2136

Tarkio 2309

7" @ 2309

TD 2317

B/15 boph Hydrofrac S/80 bo 8 hr.

S/8 boph 9 hr. Comp. 70 boph

