Barton


KANSAS

FORM 51 IOM 12-46 PETROL

Section 32 Township 18 Range 15-W

Well No. #2 Anderson

Company E. R. Rabon etal
Albert Pool

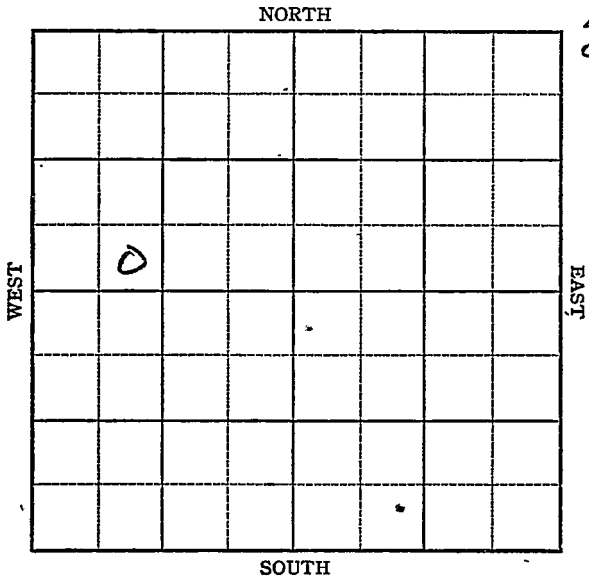


FORM 252-A
5M 12-46 PETROL

Barton KANSAS ✓

Sec. 32 Twp. 18 R. 15-W

Well No. # 2 Anderson Farm
E. R. Rabon etal Company
Albert Pool

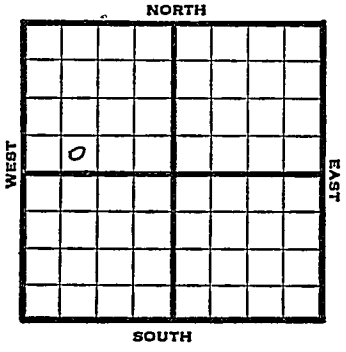

_____ Ft. from N. Line

330 Ft. from S. Line

_____ Ft. from E. Line

990 Ft. from W. Line

Se Sw NW

1947	Elev. 1959' REPORT
6/18	Location
6/24	8" @ 990' Drlg 1442'
7/1	Drlg 2965'
7/8	Lansing 3254' BKC 3500' Reagan 3523' TD 3548 5" @ 3538' RUST
7/16	TD 3580' 20 qts. CO
7/22	50 qts. Fsg.
7/29	Estimate 3 bbls. oil a day
8/6	"
8/13	"
8/20	"
8/27	"

OVER

1947

9/3 Reagan 3523'
5" @ 3538'
Pump 16 Pot
36.0 Gr.
TD 3580'

COMPLETED

Form 26 200 Bks. 10-46 Petrol

Albert Pool

Kansas

Map No. _____ Sec. 32 Twp. 18 R. 15W


Well No. 2 Anderson

E. R. Rabon etal. Company

FIRST REPORT Contractor

SE SW NW

SECTION PLAT

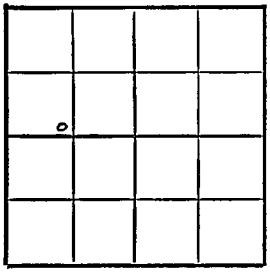

_____ Ft. from N. Line

330 Ft. from S. Line

_____ Ft. from E. Line

990 Ft. from W. Line

Barton County

Location X

Rig up _____

Drilling and Remarks:

RECORD

Cased _____ in., _____ ft.

Sand _____

Gas _____

Oil _____

Total Depth _____

PRODUCTION

1st 24 hrs. Nat. _____

1st 24 hrs. after shot _____

Gas _____ Cu. Ft.

Dry Hole _____

Abandoned _____

Date

JUN 1 8 1947 19 S. J. LEWIS Scout

Albert Pool

Form 26 200 Bks. 10-46 Petrol
Kansas

Map No. 73 Sec. 32 Twp. 18 R. 15W

Well No. 2 Anderson

E. R. Rabon etal. Company


COMPLETE

Contractor

SE SW NW

E.L. 1959

SECTION PLAT

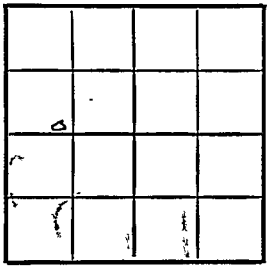

Ft. from N. Line

330 Ft. from S. Line

Ft. from E. Line

990 Ft. from W. Line

Barton County

Location

Rig up

Drilling and Remarks:

Reagan 3523

S-M 3568

Pump 16 BO

26 BO

RECORD

Cased in., ft.

Sand

Gas

Oil

Total Depth 3568

PRODUCTION

1st 24 hrs. Nat.

1st 24 hrs. after shot

Gas Cu. Ft.

Dry Hole

Abandoned

Date

SEP 3 1947 19

S. J. LEWIS Scout