Form No. PO-151 A—10M—4-37

Texas CO

H.S. Taylor July '45

STATE KANSAS	**COMPANY** VICKERS	
COUNTY KINGMAN	**FARM** CARRICK	**WELL NO.** 1
T. 30 **R.** 8W	**DIVISION**	**DISTRICT**
SURVEY SWc NW	**KIND OF RIG**	
o 28	**COMMENCED** 5-6-45	
	COMPLETED 6-13-45	
	REMARKS	
ELEV. 1641		
PRODUCTION		
INITIAL **SETTLED**		

CASING AND SCREEN RECORD

10" @ 168'

5" 4580'

SHOT	**QUARTS**	**BETWEEN**

100

200

300

400

500

600

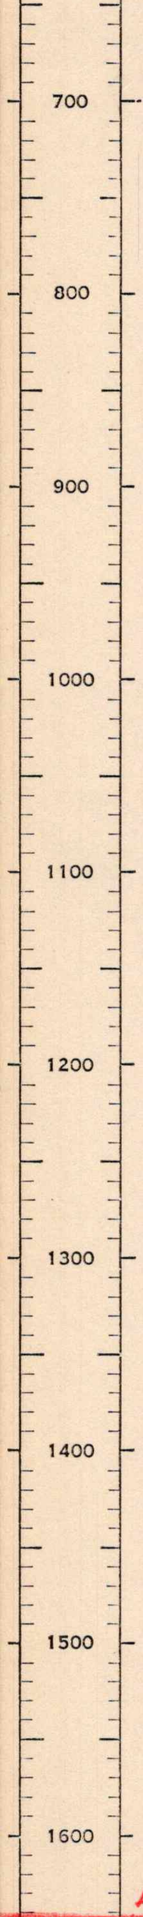

41

M.S.L.

1700

1800

1900

2000

2100

2200

2300

2400

2500

2600

2700

2800

2900

3000

3100

3200

3300

3400

3500

LANSING

3555
1641
-1914

3600

3700

3800

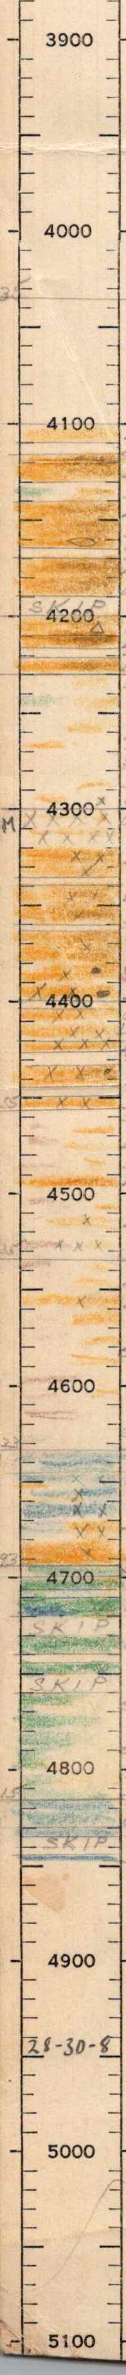

4035
1641
-2394

BASE K.C.
MARMATON

-2394

samples start.

Ls. blk. vry Fnly xLN.
sh. dk. gry. to blk.
Ls. wh. to TAN sub to crsly xLN.
sd. brn. vry Fine. micac.
Ls. TAN + brn Fnly to crsly xLN.
some TAN Ls. dense sub xLN. Litho.
Fusilinid
sh. dk. gry.
Ls. TAN crsly xLN. MARMATON
Ls. TAN Fnly + crsly xLN

some ööl. LS.
Ls. TAN + blk. sub + Fnly xLN. some Litho.
sh. dk. gry.
Ls. TAN + blk. sub. Litho. + Fnly xLN
sh. dk. gry.
Tra. sd. brn. Fine micac.

Pyrite
some Ls. dense TAN + grn. Litho.
sh. dk. gry.
sh. dk. gry.
ch. wh. vit. opaq.
ch. wh. to TAN VIT opaq. Ls. TAN + grn Litho.
some devit.

MISS

Ls. TAN + grn. sub xLN dense Litho.

Ls. TAN sub + crsly xLN. ch. wh to TAN

sh. gry
Ls. wh. to TAN crsly xLN.

4300
1641
-2659

V. S. S. O.
Ls. TAN. crsly xLN. ch. TAN vit opaq.
ch. TAN vit. opaq. + wh.
Ls. TAN sub some dense Litho + Fnly xLN
Ls. wh. Fnly to crsly xLN. ch. TAN VIT. opaq.
sh. dk. gry.
V. S. S. O.
some grn. Ls. sub xLN dense
sh. dk. gry
Ls. wh. Fnly xLN. ch. wh. to TAN vit. opaq.
sh. dk. gry
Ls. wh. grn + brn. sh. gry + brn.
sh. dk. gry
Ls. wh., TAN + brn. Fnly to crsly xLN.
sh. dk. gry.
Ls. TAN, grn + brn. sub xLN dense

BAD SAMPLES (ALL Lime)

Ls. TAN + grn sub xLN.
Ls. TAN Fnly to crsly xLN.

KINDERHOOK

sh. dk. gry.

4535
1641
-2894

sh. gry. + grn.

VIOLA

dol. TAN + brn b/d. ch. TAN +gry VIT. opaq.

4633
1641
-2992

ch. TAN + gry opaq.
Ls. ch. dull gry grn. to blue sub xLN. dense Litho.
Ls. TAN Fnly to crsly xLN.
ch. dull gry opaq. some crsly xLN Ls.
sd. wh. med to crse. glassy.
dol. Lt. gry. vry vry Fnly xLN. SIMPSON

4693
1641
-3052

sd. wh. to Lt. gry crse. glassy.

sd. wh. crse + med. glassy. sh. gry

sd. wh. crse glassy.
sh. gry.

dol. Tan. Fnly xLN ARBUCKLE

4815
1641
-3174

T.D. 4848

D & A

28-30-8