7-54

STATE	Kansas
COUNTY	Kingman
BLOCK	
SEC.	19
T.	30
R.	7w
ALTITUDE	1518
PRODUCTION	
COMPANY	Pickrell Drlg.
FARM	Tjaden
WELL NO.	1
SURVEY	
TOTAL DEPTH	4328'
	Nw-Nw-Sw
COMMENCED	
COMPLETED	
REMARKS	

CASING RECORD


DST 4202-30/1hr. 180' oil + 6CM BHP 760#.
DST 4220-50/1hr. 90' oil + GCM 120' HO + GCM 100' Mdy. GCO 20' wtr. BHP 900#.
DST 4250-80/1hr. 90' O + GCM, 300' oil + GSy. Mud, Tr. wtr. BHP 1000#.

SHOT	QUARTS	BETWEEN

FORM 186 - In stock and for sale by Ross-Martin Co., Tulsa

R.B.S.

Samples Start @ 3000'

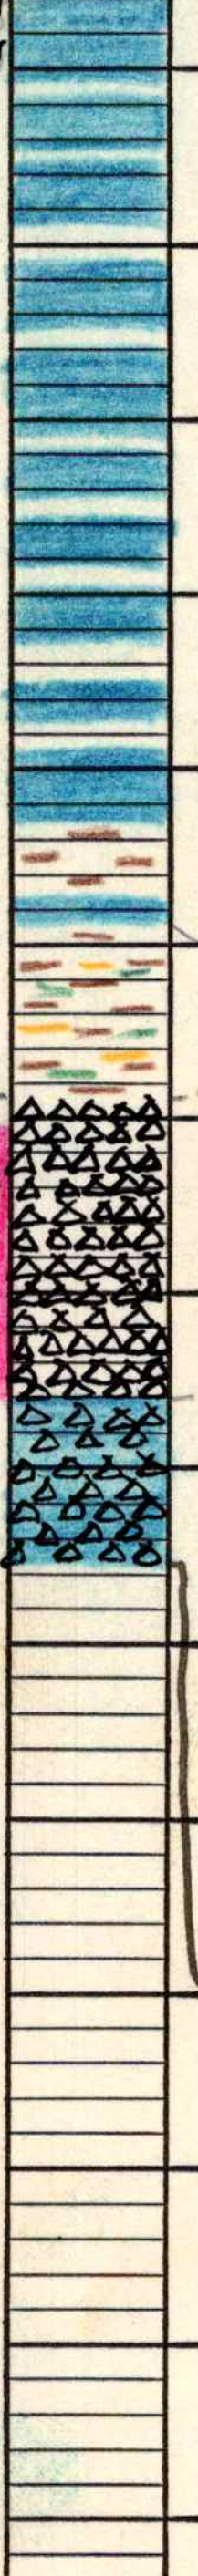

crm ltgry f. foss
crm gry fd foss
gry fd
gry bt fd
crm gry fd foss
bl k sh
gry bt to brn fd
dk gry to blk sh
HEEBNER 3150
crm gry fd
r + g sh. interbedded w/ gry f gr. subc micac sst.
gry f gr subc micac sst shaley.
LANSING 3388
gry bt fd foss
lt gry fd
crm f foss lst.
crm gry f foss
gry bt to brn fd foss
bt to brn f foss
gry bt fd foss
gry bt fd
crm gry fd foss slay
crm gry fd
gry bt fd sy
crm gry fd
gry bt oolic por. ls.
gry bt fd
dk gry fd
crm gry fd
crm gry fd foss
wh crm fd
gry bt fd
crm gry bt fd foss
gry bt fd
r + g sh
gry bt fd
v col sl sdy sh.
MISS 4194
wh bt fd to subopq residual & por & spotty oil stn.
wh ltgry f to med xln ay lst.

T.D. 4328'