2-58

STATE Kansas	COMPANY Pet. Inc
COUNTY Kingman	FARM Spade 'E' · WELL NO. 1
BLOCK	SURVEY
SEC. 22	TOTAL DEPTH 4723
T. 29 · R. 10W	NW-NW-SE
	COMMENCED
	COMPLETED
ALTITUDE 1766	REMARKS Electrolog
PRODUCTION D&A	

CASING RECORD

DST 4312-22/1HR, 60'G, 30'M
SPKS 0 BHP 0#
DST 4324-60/1HR, 160'M, 120'W
BHP 1380#

SHOT · QUARTS · BETWEEN


FORM 186 - In stock and for sale by Ross-Martin Co., Tulsa

DST 4599-4603/1HR, 1560' SIP, 120' HG+SL OCM # 1140 'SW, SHO, BHP 1700
DST 4663-75/1HR, 35'M BHP 1720#

1666
1153
1153 | 513
171

605 · 560
605
548
1153

SAMPLES START @ 3300

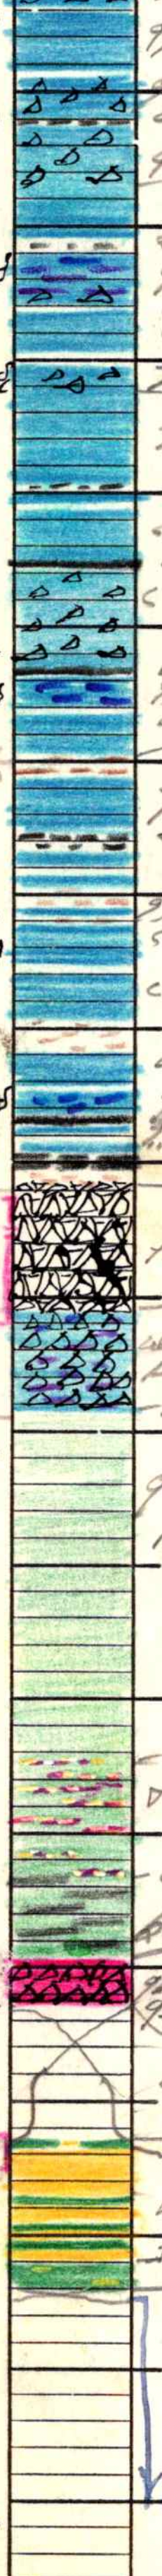

Heebner Sh 3563

Ls 3733

Miss 4307

Khk Sh 4392

Viola 4597

Su 4665 ... higher in skip

Samples 4720
skip 20 to T.D.

TOTAL DEPTH 4723

Note: Samples 4615-65 didn't come out of this hole! Probably accidentally mixed up with another set of samples cut at same time