E W
15 Range
S
32 Township
27 Section

Barber
County

Hildebrand No. 9
Farm

Champlin Refg. Co
Company

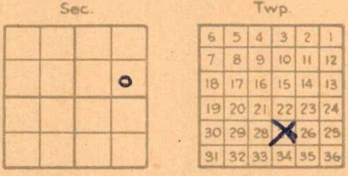
Sec.
Twp.
6
5
4
3
2
1
7
8
9
10
11
12
18
17
16
15
14
13
19
20
21
22
23
24
30
29
28
X
26
25
31
32
33
34
35
36

Elev. 1848 sct. T.D. 4903'

Date Drilled 1-11-47

Correlation by

Prod.- Phy. Pot. : 251 BO

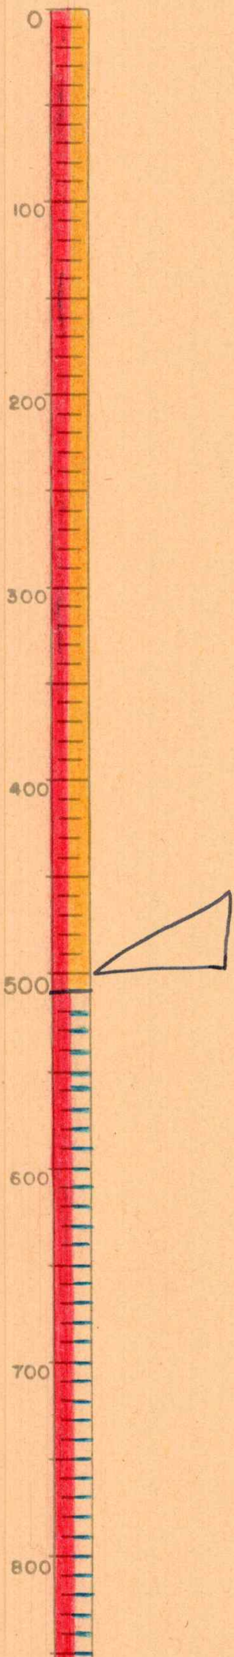

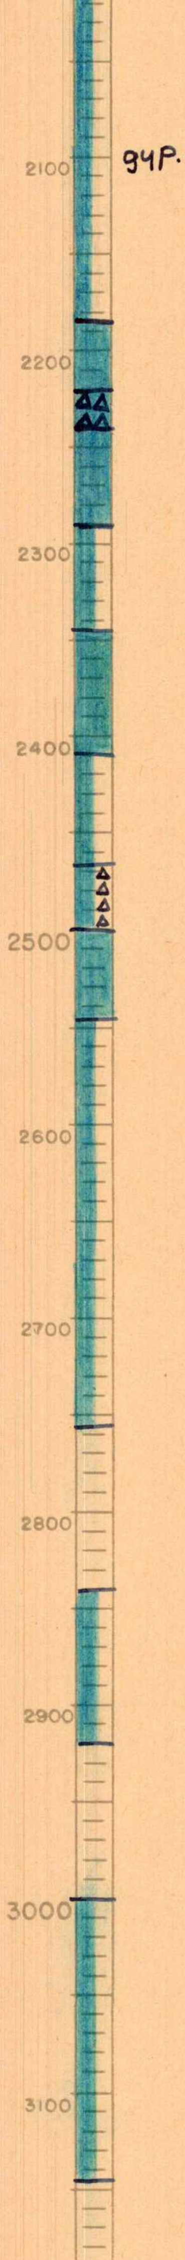
gyp.
2100
2200
2300
2400
2500
2600
2700
2800
2900
3000
3100

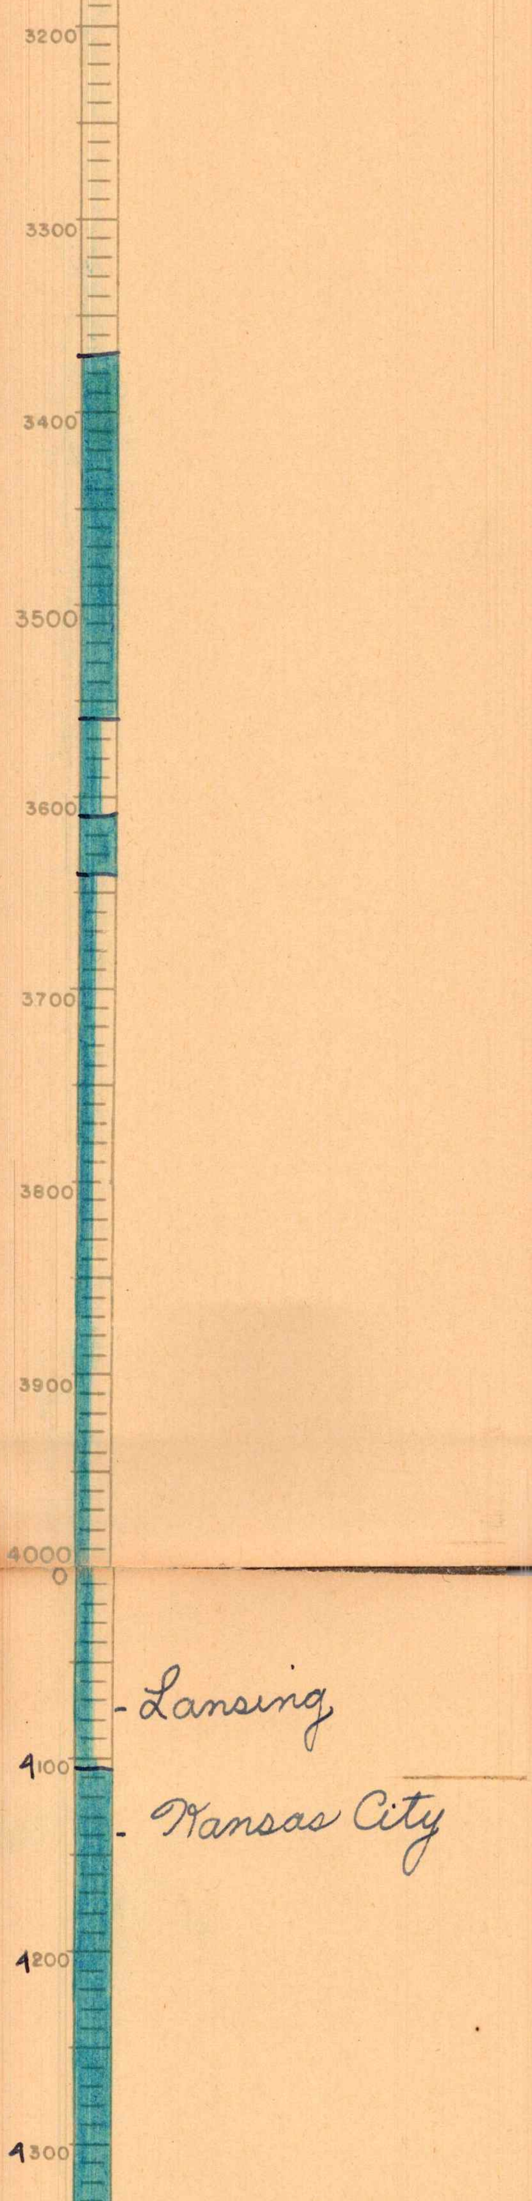
3200
3300
3400
3500
3600
3700
3800
3900
4000
0
- Lansing
4100
- Kansas City
4200
4300

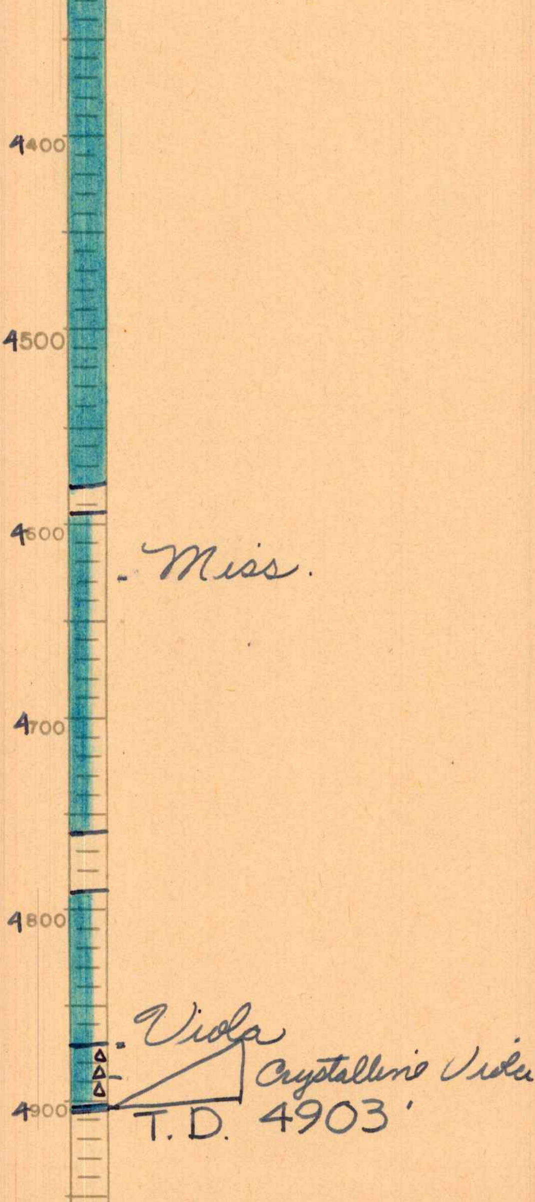
4400
4500
4600
4700
4800
4900

Miss.

Viola

Crystalline Viola

T.D. 4903'