Texas CO.

P. O. 151 8-27-5M

STATE Kans

COUNTY Barber

T. 33 | R. 13W

SURVEY 13

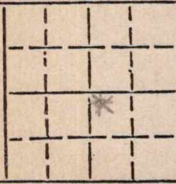

ELEV. 1609LS

PRODUCTION

INITIAL 5A | SETTLED

COMPANY Barbara

FARM Alexander WELL NO 1

DIVISION | DISTRICT

KIND OF RIG CT

COMMENCED 5-9-26

COMPLETED 1-18-27

REMARKS NW-SE

CASING AND SCREEN RECORD

SHOT QUARTS BETWEEN

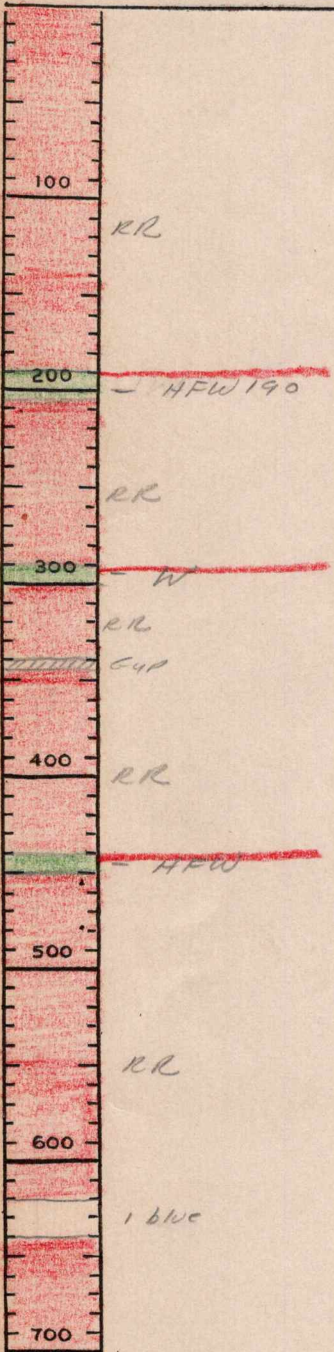

100
RR
200
HFW 190
RR
300
W
RR
Gyp
400
RR
HFW
500
RR
600
1 blue
700

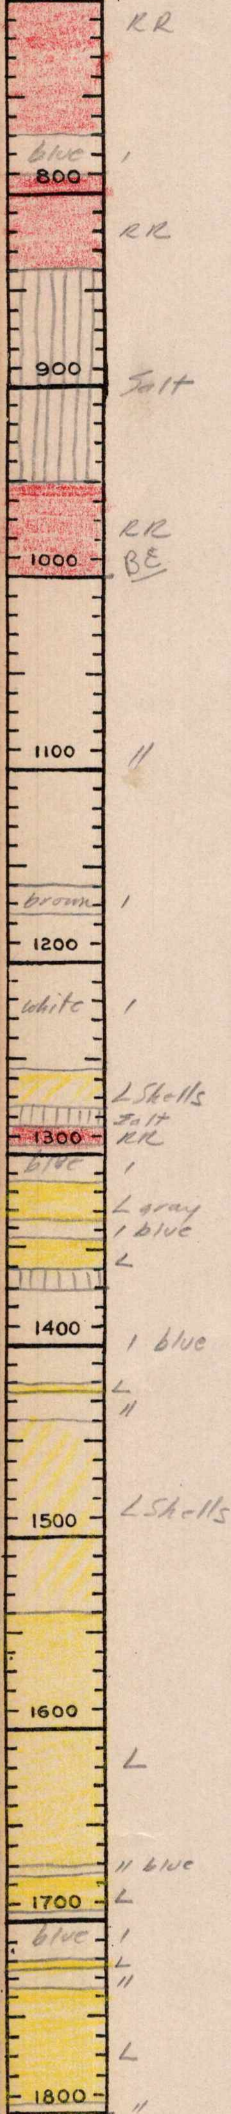
RR
blue
1
800
RR
900
Salt
RR
BE
1000
1100
11
brown
1
1200
white
1
L Shells
Salt
1300
RR
blue
1
L gray
1 blue
L
1400
1 blue
L
11
1500
L Shells
1600
L
11 blue
1700
L
blue
1
L
11
L
1800
11

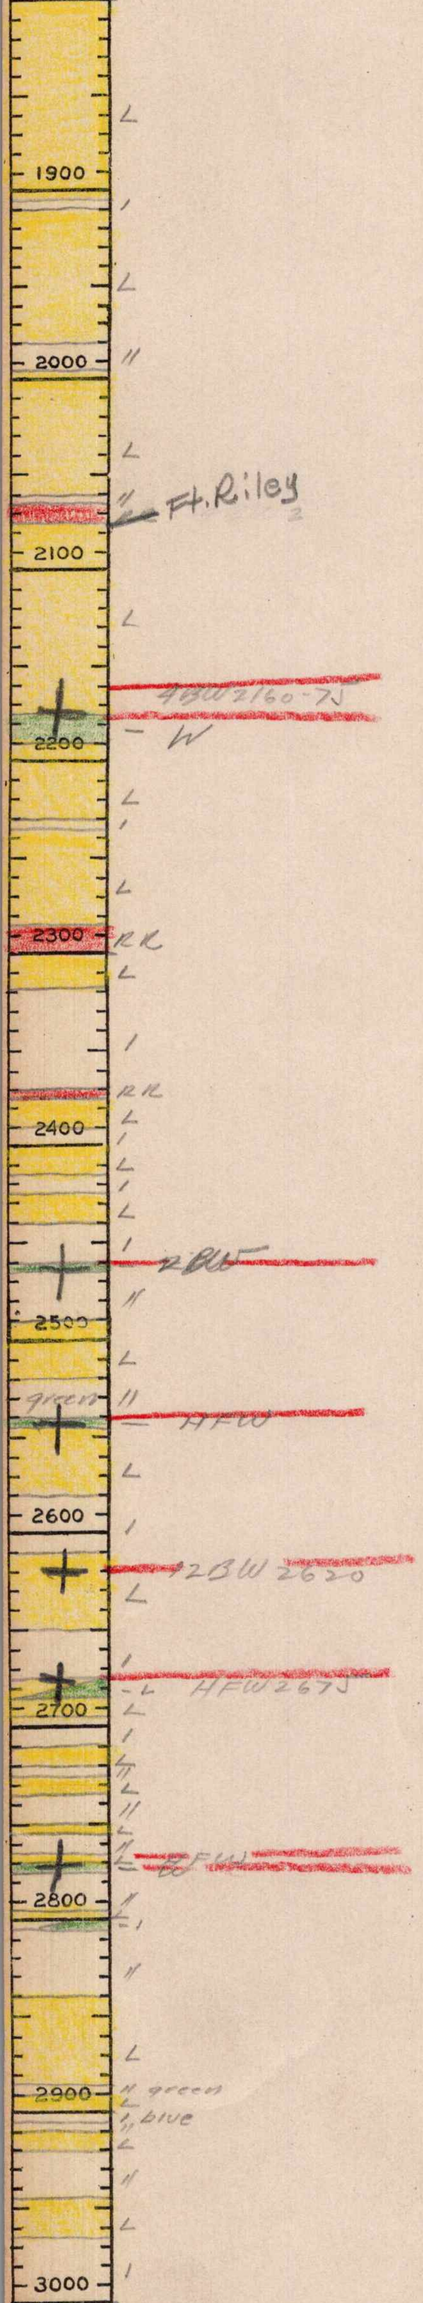
1900
2000
Ft. Riley
2100
4BW 2160-75
W
2200
2300
RR
RR
2400
2BW
2500
green
HFW
2600
12BW 2620
HFW 2675
2700
BFW
2800
2900
green
blue
3000

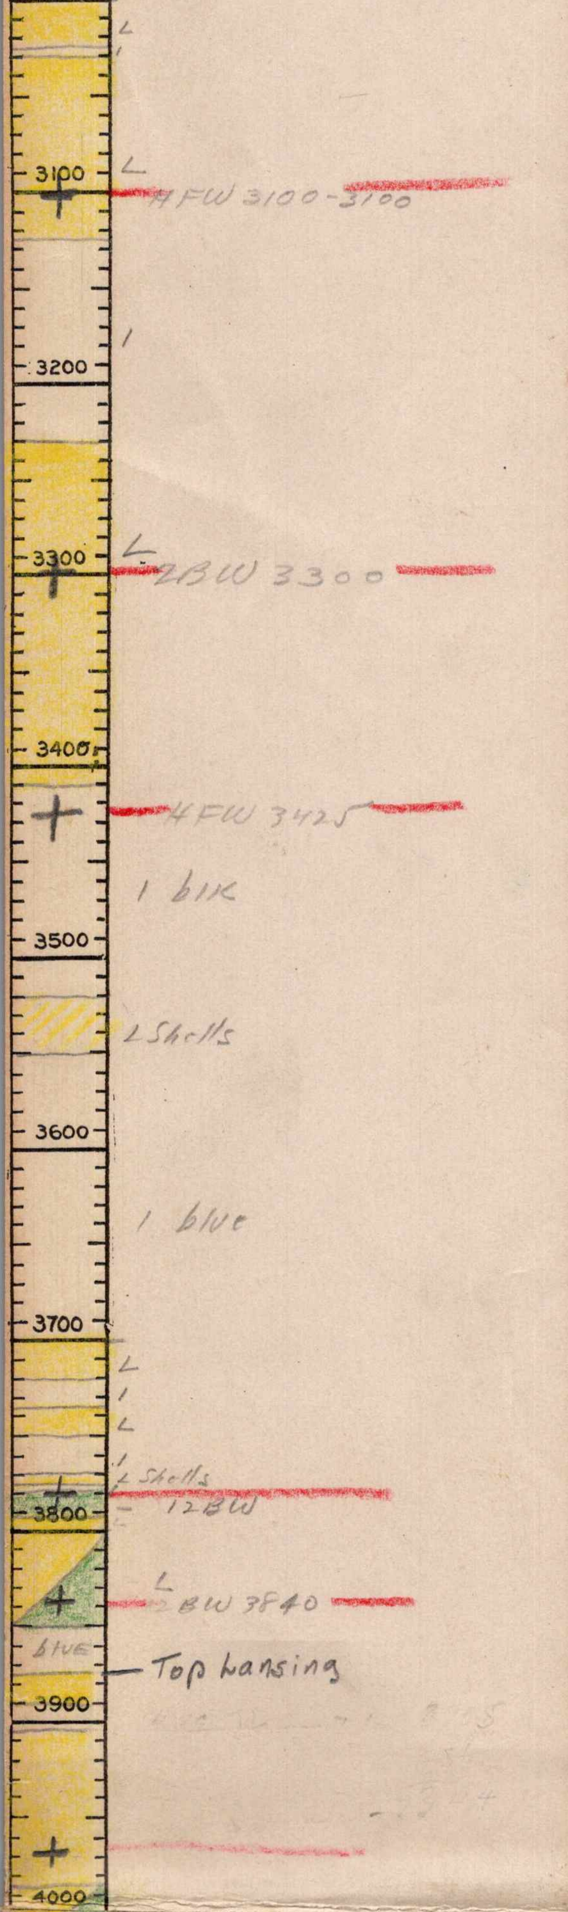
3100
L
L
HFW 3100-3100
3200
3300
L
2BW 3300
3400
HFW 3425
1 blk
3500
L Shells
3600
1 blue
3700
L
L
L Shells
12BW
3800
L
2BW 3840
blue
Top Lansing
3900
4000

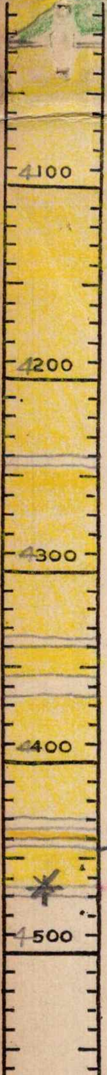
4100
4200
4300
4400
4500

4445.
1601
2844

Top Chat.

[illegible] SA Gas

TD 4470