13-33-13W

33
13x

Barber.
WLB ?

13

comp ?
comm ?

Altkonder
1
Barbara Oil.

1561

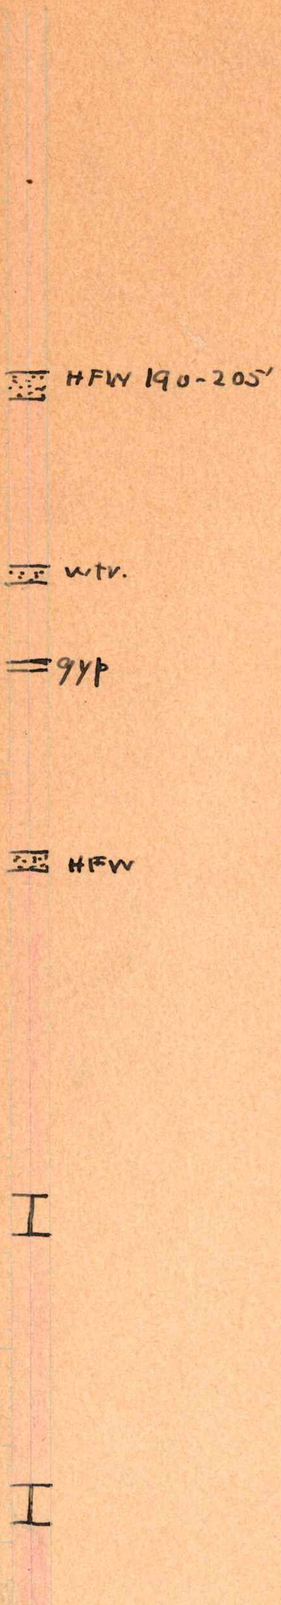
HFW 190-205'
wtr.
gyp
HFW

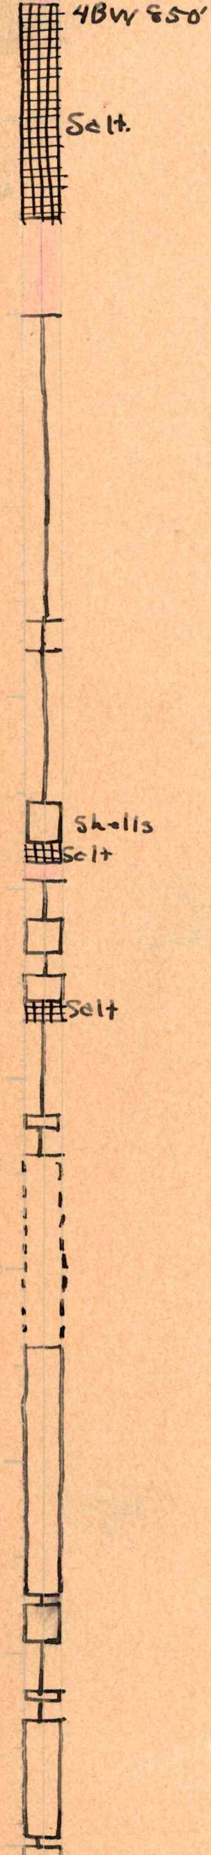
4BW 850'
Salt.
Shells
Salt
Salt
1500

2

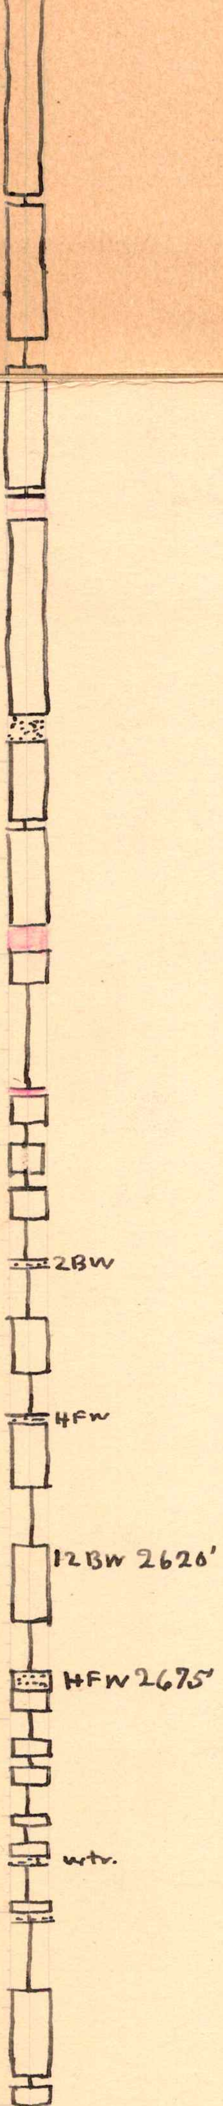
2BW
4FW
12BW 2620'
4FW 2675'
wtr.

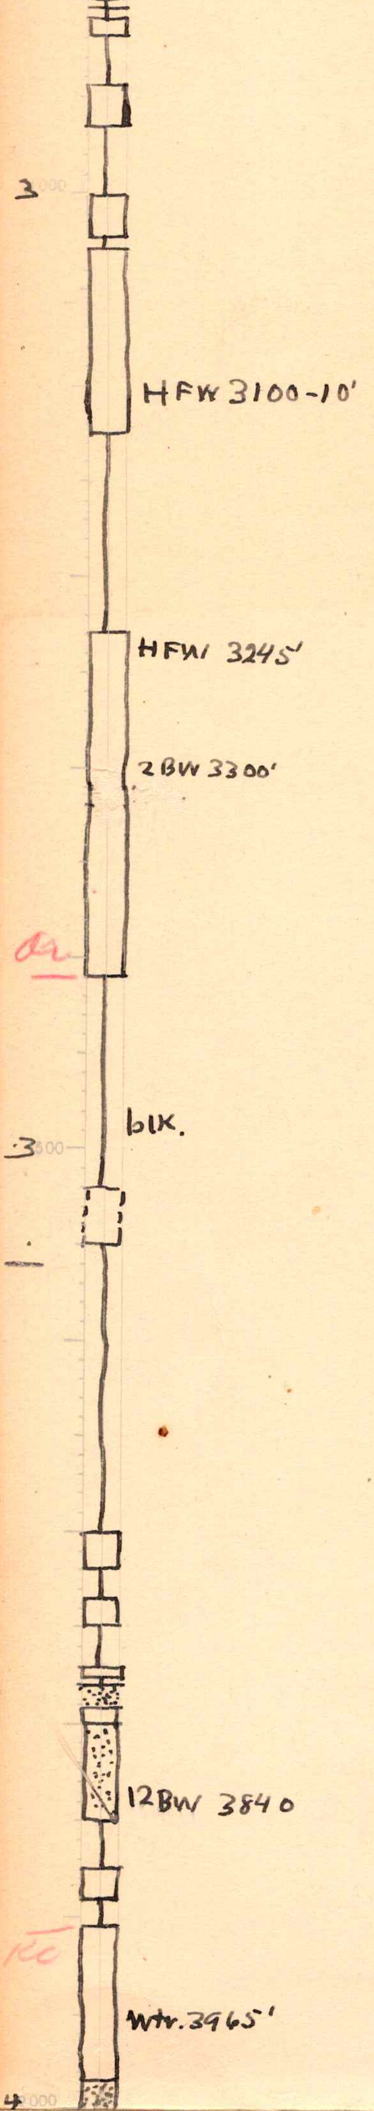
3000
HFW 3100-10'
HFW 3245'
2BW 3300'
Oa
blk.
3500
12BW 3840
Kc
Wtr. 3965'
4000

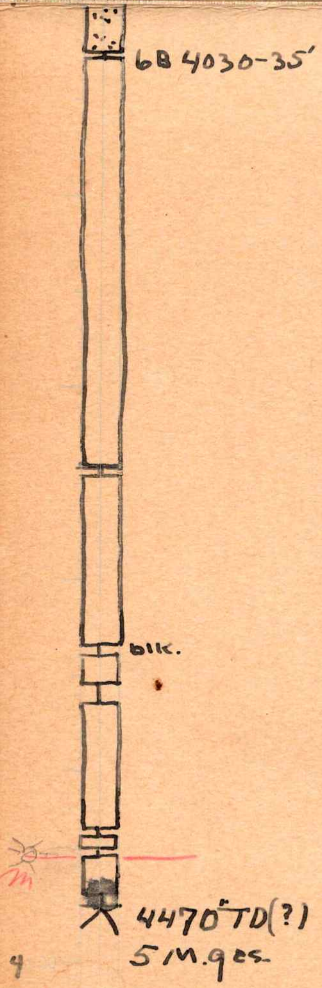
6B 4030-35'
blk.
m
4470' TD(?)
5 M. gas

4