

KANSAS

Leavenworth


FORM 51 5M 10-41 PETROL

15 103 00031 0000

Section 1 - Township 10 Range 20-E

Well No. 1 Bell

Company Mosbacher et al

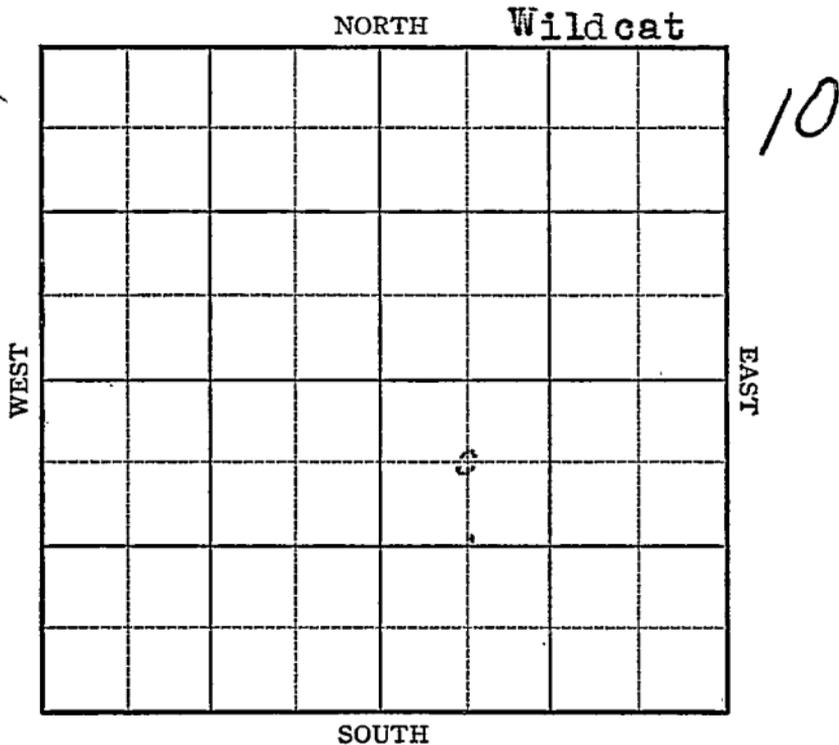

Sec. I Twp. 10 R. 20-E

Well No. #1 Bell Farm  
Mosbacher et al Company


(Wildcat)

660 Ft. from N. Line

\_\_\_\_\_ Ft. from S. Line

\_\_\_\_\_ Ft. from E. Line

660 Ft. from W. Line

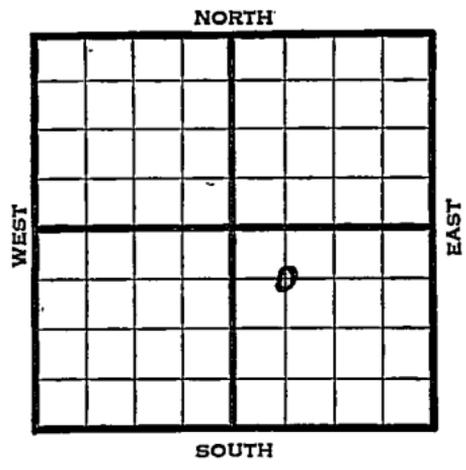

1942	REPORT
1/7	Spud.
1/15	"
1/22	"
1/29	"
2/5	Spud & SD.
2/12	" "
2/19	" "
2/26	" "
3/5	" "
3/11	" "
3/19	" "
3/26	" "
4/2	" "
4/8	" "
4/15	" "
4/22	" "
4/29	" "
5/6	" "
5/13	10" - 25' Drlg. 620'
5/20	6" - 1116' Drlg. 1380'

**OVER**

1942

5/27

Bart. 1343' 5" - 1343'  
T.D. 1368' 5.8 M gas.

6/3

" " "

6/10

Bart. 1343'  
5" - 1343'  
T.D. 1368'  
5,800,000 cu. ft. gas.

**COMPLETED**

Map No. NM Sec. 1 Twp. 10 R. 20EWell No. 1 BellMosbacher et al. CompanyFIRST REPORTS Contractor

## SECTION PLAT

		o	

C NW SE

660 Ft. from N. Line

\_\_\_\_\_ Ft. from S. Line

\_\_\_\_\_ Ft. from E. Line

660 Ft. from W. Line

## WILDCAT

## RECORD

Location \_\_\_\_\_

Cased \_\_\_\_\_ in., \_\_\_\_\_ ft.

Rig up \_\_\_\_\_

Sand \_\_\_\_\_

Drilling and Remarks:

Gas \_\_\_\_\_

Oil \_\_\_\_\_

Spud \_\_\_\_\_

Total Depth \_\_\_\_\_

## PRODUCTION

1st 24 hrs. Nat. \_\_\_\_\_

1st 24 hrs. after shot \_\_\_\_\_

Gas \_\_\_\_\_ Cu. Ft.

Dry Hole \_\_\_\_\_

Abandoned \_\_\_\_\_

Date

JAN 7 1942 19 \_\_\_\_\_S. J. LEWIS Scout

Base. Small Maps	
Cards	<i>Prof</i>
Tracing	
France Map	

Leavenworth KANSAS

Map No. MM Sec. 1 Twp. 10 R. 20EWell No. 1 BellMosbacher et al. Company**COMPLETED** Contractor

C NW SE

660 Ft. from N. Line         Ft. from S. Line         Ft. from E. Line660 Ft. from W. Line

WILDCAT

## SECTION PLAT

		2	

## RECORD

Location                                 Cased          in.,          ft.Rig up                                 Sand                                 

Drilling and Remarks:

Gas                                 Box 1343Oil                                 5" @ 1343Total Depth 13685,500,000 cu ft  
Gas

## PRODUCTION

1st 24 hrs. Nat.                                 1st 24 hrs. after shot                                 Gas                                  Cu. Ft.Dry Hole                                 Abandoned                                 

Date

JUN 10 1942 19S. J. LEWIS Scout

Misc Small Maps	<del>X</del>
Cards	<del>X</del>
Tracing	
France Map	
Scarborough Map	<del>X</del>
Moody Map	
Geological Dept.	
Moody Plat Book	