

# KANSAS


Leavenworth

FORM 51 5M 10-41 PETROL

Section 1 Township 10 Range 20-E

Well No. #2 Borst

Company McLaughlin

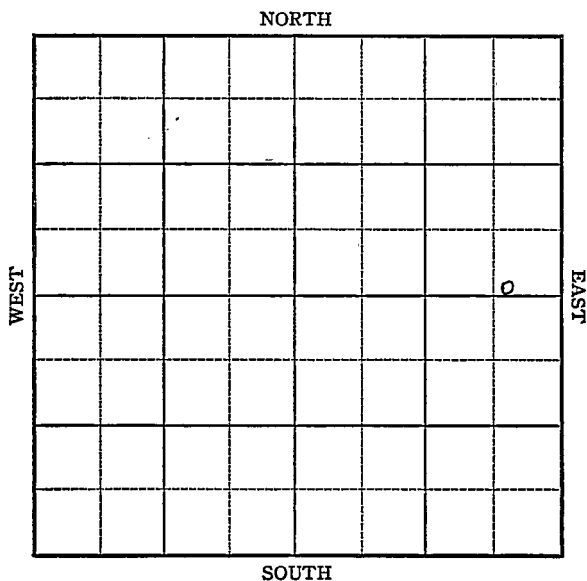

**KANSAS**

Leavenworth

Sec. 1 Twp. 10 R. 20-E

Well No. #2 Brost Farm

McLaughlin Company


McLouth

\_\_\_\_\_ Ft. from N. Line

150 Ft. from S. Line

500 Ft. from E. Line

\_\_\_\_\_ Ft. from W. Line

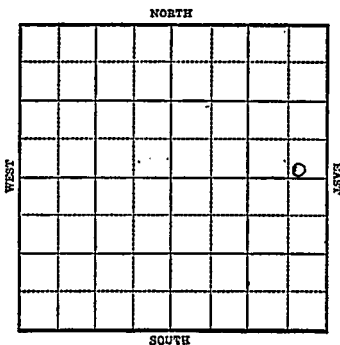

C SL SE NE

1943

R E P O R T

2/3 10" Casing set 40'  
Drlg. 420'.

2/10 8" @ 699'  
Drlg. 795'

2/17 Miss. 1471  
T/D. 1474'  
No shows.

**ABANDONED**

Leavenworth

KANSAS

Map No. 1114 Sec. 1 Twp. 10 R. 20E

Well No. 2 Borst

McLaughlin Company

FIRST REPORT Contractor

C SL SE NE

\_\_\_\_\_ Ft. from N. Line

150 Ft. from S. Line

500 Ft. from E. Line

\_\_\_\_\_ Ft. from W. Line

SECTION PLAT

			o

MCLOUTH POOL

Location \_\_\_\_\_

Rig up \_\_\_\_\_

Drilling and Remarks:

10"-40'

Dr1g. 420'

RECORD

Cased \_\_\_\_\_ in., \_\_\_\_\_ ft.

Sand \_\_\_\_\_

Gas \_\_\_\_\_

Oil \_\_\_\_\_

Total Depth \_\_\_\_\_

PRODUCTION

1st 24 hrs. Nat. \_\_\_\_\_

1st 24 hrs. after shot \_\_\_\_\_

Gas \_\_\_\_\_ Cu. Ft.

Dry Hole \_\_\_\_\_

Abandoned \_\_\_\_\_

Date

FEB 3 1943 19

S. J. LEWIS Scout

KANSAS

Leavenworth

Map No. NM Sec. 1 Twp. 10 R. 20E

Well No. 2 Borst

McLaughlin Company

ABANDONED Contractor

C SL SE NE

SECTION PLAT

\_\_\_\_\_ Ft. from N. Line

150 Ft. from S. Line

500 Ft. from E. Line

\_\_\_\_\_ Ft. from W. Line

			o

MCLOUTH POOL

Location \_\_\_\_\_

Rig up \_\_\_\_\_

Drilling and Remarks:

*Misc 1471*  
*Nochrowe*

RECORD

Cased \_\_\_\_\_ in., \_\_\_\_\_ ft.

Sand \_\_\_\_\_

Gas \_\_\_\_\_

Oil \_\_\_\_\_

Total Depth 1474

PRODUCTION

1st 24 hrs. Nat. \_\_\_\_\_

1st 24 hrs. after shot \_\_\_\_\_

Gas \_\_\_\_\_ Cu. Ft.

Dry Hole \_\_\_\_\_

Abandoned \_\_\_\_\_

Date

FEB 17 1943 19

S. J. LEWIS Scout