

# KANSAS

FORM 51 5M 10-41 PETROL

Jefferson

15 103 ~~0000~~ 30 0000


Section 1 Township 10 Range 20-E

Well No. #3 Bell

Company Mosbacher

McLouth Pool

NORTH

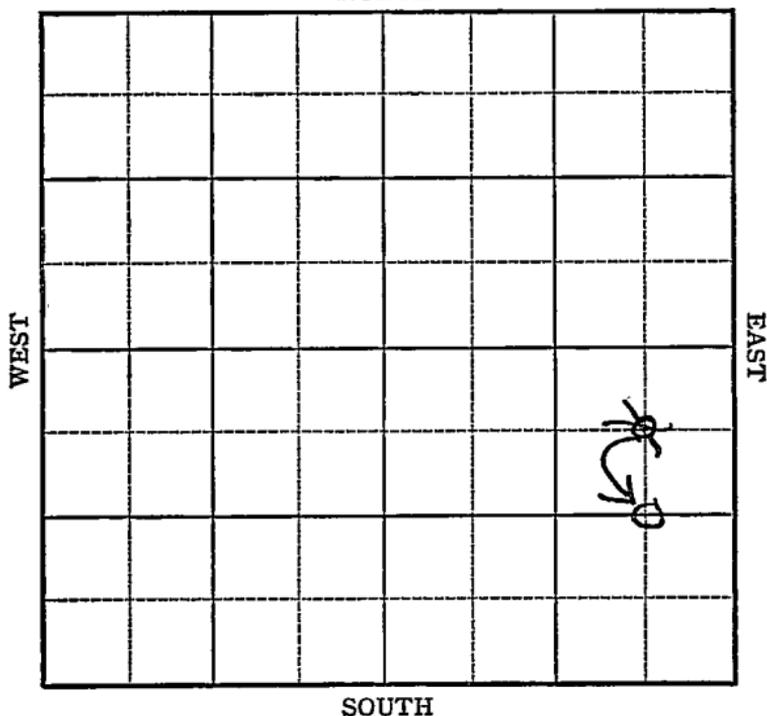

Sec. 1 Twp. 10 R. 20-E

Well No. #3 Bell Farm

Mosbacher Company

(McLouth Pool)


*1320*

660 Ft. from N. Line

\_\_\_\_\_ Ft. from S. Line

660 Ft. from E. Line

\_\_\_\_\_ Ft. from W. Line

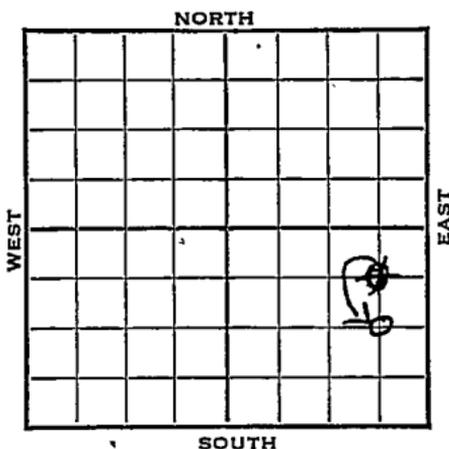

1942

REPORT

8/27 Spud 30'

9/2 S.D. 648'

9/9 Drlg 835

9/16 8" @ 835 Drlg 1195

9/23 Sand 1385

5" 1384

TD 1396

7 M Gas


COMPLETED

Jefferson

KANSAS

Map No. NM Sec. 1 Twp. 10 R. 20EWell No. 3 BellMosbacher CompanyCOMPLETED ContractorC E  $\frac{1}{2}$  SE

## SECTION PLAT

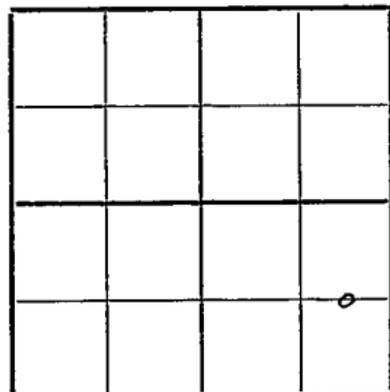1320 Ft. from N. Line         Ft. from S. Line660 Ft. from E. Line         Ft. from W. Line

MCLOUTH POOL

Location \_\_\_\_\_

Rig up \_\_\_\_\_

Drilling and Remarks:

*Sand 1385**5" @ 1384**7M Gas*

## RECORD

Cased \_\_\_\_\_ in., \_\_\_\_\_ ft.

Sand \_\_\_\_\_

Gas \_\_\_\_\_

Oil \_\_\_\_\_

Total Depth 1396

## PRODUCTION

1st 24 hrs. Nat. \_\_\_\_\_

1st 24 hrs. after shot \_\_\_\_\_

Gas \_\_\_\_\_ Cu. Ft.

Dry Hole \_\_\_\_\_

Abandoned \_\_\_\_\_

Date

SEP 23 1942 19S. J. LEWIS Scout

KANSAS

Jefferson

Map No. NM Sec. 1 Twp. 10 R. 20EWell No. 3 BellMosbacher

Company

**FIRST REPORT**

Contractor

C N E S E

660 Ft. from N. Line

\_\_\_\_\_ Ft. from S. Line

660 Ft. from E. Line

\_\_\_\_\_ Ft. from W. Line

## SECTION PLAT

			o

## MCLOUTH POOL

Location \_\_\_\_\_

Rig up \_\_\_\_\_

Drilling and Remarks:

Spud 30'

## RECORD

Cased \_\_\_\_\_ in., \_\_\_\_\_ ft.

Sand \_\_\_\_\_

Gas \_\_\_\_\_

Oil \_\_\_\_\_

Total Depth \_\_\_\_\_

## PRODUCTION

1st 24 hrs. Nat. \_\_\_\_\_

1st 24 hrs. after shot \_\_\_\_\_

Gas \_\_\_\_\_ Cu. Ft.

Dry Hole \_\_\_\_\_

Abandoned \_\_\_\_\_

Date

AUG 27 1942

19

S. J. LEWIS

Scout

Jefferson


Map No. MM Sec. 1 Twp. 10 R. 20EWell No. 3 BellMosbacher CompanyCORRECTION ContractorC  $E\frac{1}{2}$  SE1320 Ft. from N. Line

\_\_\_\_\_ Ft. from S. Line

660 Ft. from E. Line

\_\_\_\_\_ Ft. from W. Line

## SECTION PLAT

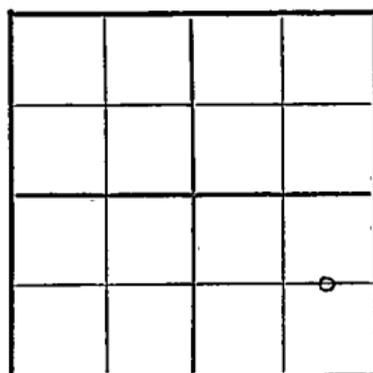

MCLOUTH POOL

Location \_\_\_\_\_

Rig up \_\_\_\_\_

Drilling and Remarks:

Reported C NE SE. PRODUCTION

## RECORD

Cased \_\_\_\_\_ in., \_\_\_\_\_ ft.

Sand \_\_\_\_\_

Gas \_\_\_\_\_

Oil \_\_\_\_\_

Total Depth \_\_\_\_\_

1st 24 hrs. Nat. \_\_\_\_\_

1st 24 hrs. after shot \_\_\_\_\_

Gas \_\_\_\_\_ Cu. Ft.

Dry Hole \_\_\_\_\_

Abandoned \_\_\_\_\_

Date

SEP 9 1942 19 \_\_\_\_\_

S. J. LEWIS Scout