


Section 1 Township ~~9~~ 10 Range 20-E

Well No. #1 Borst

Company McLaughlin

NORTH McLouth Pool

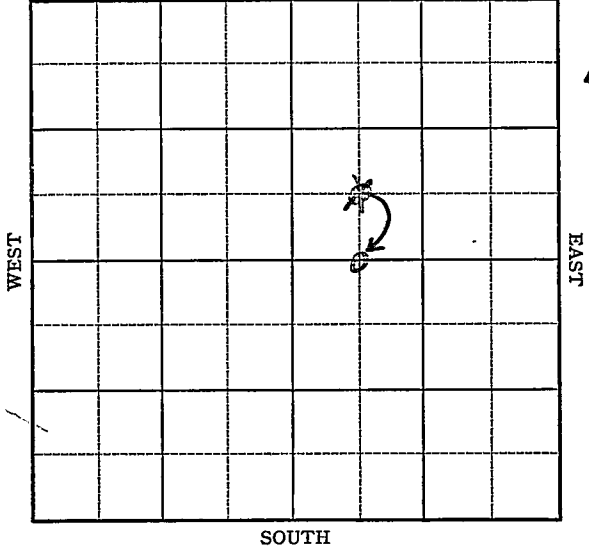

Map No. MM Sec. 1 Twp. 10 R. 20E


Well No. 1 Borst

McLaughlin Company

ABANDONED Contractor

C $W\frac{1}{2}$ $E\frac{1}{2}$

SECTION PLAT

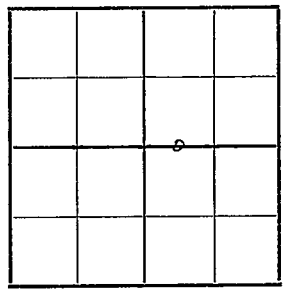

2640 Ft. from N. Line

_____ Ft. from S. Line

_____ Ft. from E. Line

660 Ft. from W. Line

MCLOUTH POOL

RECORD

Location _____

Cased _____ in., _____ ft.

Rig up _____

Sand _____

Drilling and Remarks:

Gas _____

Oil _____

Miss 1473

Total Depth 1502

No shows

PRODUCTION

1st 24 hrs. Nat. _____

1st 24 hrs. after shot _____

Gas _____ Cu. Ft.

Dry Hole _____

Abandoned _____

Date

JUN 17 1942 19

S. J. LEWIS Scout

Map No. MM Sec. 1 Twp. 10 R. 20E

Well No. 1 Borst

McLaughlin Company

CORRECTION Contractor

C SW NE

SECTION PLAT

 Ft. from N. Line

660 Ft. from S. Line

 Ft. from E. Line

660 Ft. from W. Line

		o	

MCLOUTH POOL

Location

Rig up

Drilling and Remarks:

Reported

1-9-20E

RECORD

Cased in., ft.

Sand

Gas

Oil

Total Depth

PRODUCTION

1st 24 hrs. Nat.

1st 24 hrs. after shot

Gas Cu. Ft.

Dry Hole

Abandoned

Date

JUN 3 1942 19

S. J. LEWIS Scout

Leavenworth

Map No. MM Sec. 1 Twp. 10 R. 20EWell No. 1 BorstMcLaughlin et al. CompanyCORRECTION ContractorC $W\frac{1}{2}$ $E\frac{1}{2}$ 2640 Ft. from N. Line

_____ Ft. from S. Line

_____ Ft. from E. Line

660 Ft. from W. Line

SECTION PLAT

		o	

MCLOUTH POOL

Location _____

Rig up _____

Drilling and Remarks:

Reported
C SW NE

RECORD

Cased _____ in., _____ ft.

Sand _____

Gas _____

Oil _____

Total Depth _____

PRODUCTION

1st 24 hrs. Nat. _____

1st 24 hrs. after shot _____

Gas _____ Cu. Ft.

Dry Hole _____

Abandoned _____

Date

6/10/42 19S. J. LEWIS Scout


Leavenworth

Map No. MM Sec. 1 Twp. 9 R. 20EWell No. 1 BorstMcLaughlin CompanyFIRST REPORT Contractor

C S W N E

 Ft. from N. Line660 Ft. from S. Line Ft. from E. Line660 Ft. from W. Line

SECTION PLAT

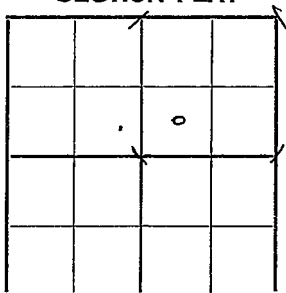

M C L O U T H P O O L

Location Rig up

Drilling and Remarks:

Machine

RECORD

Cased in., ft.Sand Gas Oil Total Depth

PRODUCTION

1st 24 hrs. Nat. 1st 24 hrs. after shot Gas Cu. Ft.Dry Hole Abandoned

Date

MAY 27 1942

19

S. J. LEWIS Scout