

KANSAS

FORM 51 5M 1-42 PETROL


Leavenworth

Section 1 Township 10 Range 20E

Well No. #1 Kessinger

Company V. W. McNabe

McLouth pool

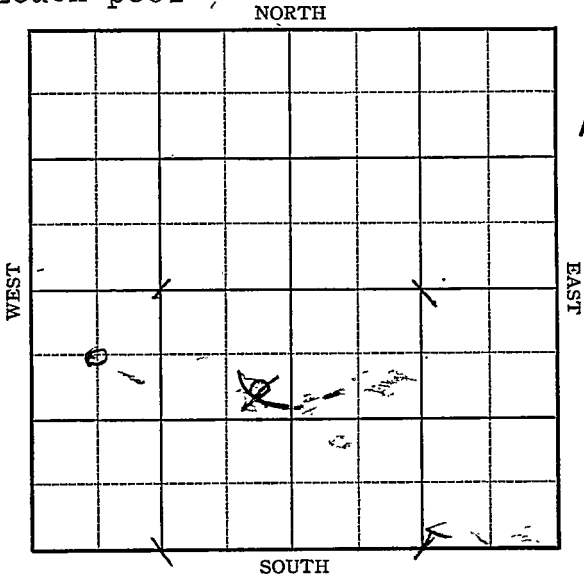

Sec. 1 Twp. 10 R. 20E

Well No. 1 Kessinger Farm

V.W. McKnabe

Company


(McLough Pool)

660 Ft. from N. Line

_____ Ft. from S. Line

_____ Ft. from E. Line

660 Ft. from W. Line

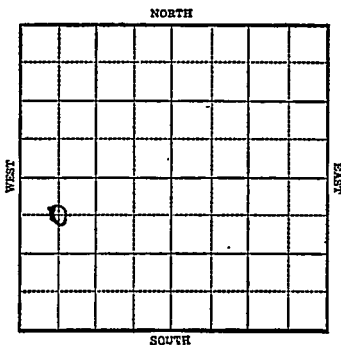

1942

R E P O R T

10/28 10" @ 29'
Drlg. 345'

11/11 5" @ 1382
Sand 1382
T.D. 1386'
Gas 724000

COMPLETED

Leavenworth

KANSAS

Map No. AM Sec. 1 Twp. 10 R. 20E

Well No. 1 Kessinger

V. W. McKnabe Company

COMPLETED Contractor

C NW SW

SECTION PLAT

660 Ft. from N. Line

_____ Ft. from S. Line

_____ Ft. from E. Line

660 Ft. from W. Line

0			

M CLOUTH POOL

Location _____

Rig up _____

Drilling and Remarks:

Sand 1382

5" @ 1382

724000 Gas

RECORD

Cased _____ in., _____ ft.

Sand _____

Gas _____

Oil _____

Total Depth 1386

PRODUCTION

1st 24 hrs. Nat. _____

1st 24 hrs. after shot _____

Gas _____ Cu. Ft.

Dry Hole _____

Abandoned _____

Date

NOV 1 1 1922

19

S. J. LEWIS

Scout

KANSAS

Leavenworth

KANSAS

Map No. MM Sec. 1 Twp. 10 R. 20E

Well No. 1 Kessinger

V. W. McKnabe Company

FIRST REPORT Contractor

C NW SW

SECTION PLAT

660 Ft. from N. Line

o			

_____ Ft. from S. Line

_____ Ft. from E. Line

660 Ft. from W. Line

McLOUTH POOL

Location _____

RECORD

Rig up _____

Cased _____ in., _____ ft.

Drilling and Remarks:

Sand _____

Gas _____

10" - 29'

Oil _____

Total Depth _____

Dr lg. 345'

PRODUCTION

1st 24 hrs. Nat. _____

1st 24 hrs. after shot _____

Gas _____ Cu. Ft.

Dry Hole _____

Abandoned _____

Date

OCT 28 1942

19

S. J. LEWIS Scout