

KANSAS

Leavenworth


FORM 51 5M 10-41 PETROL

Section 1 Township 10 Range 20-E

Well No. #1 R. B. Kesinger

Company Magnolia

NORTH Leavenworth Pool

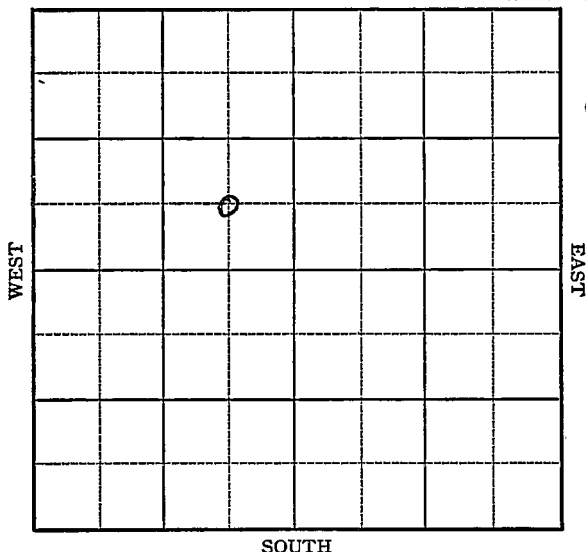

KANSAS

Leavenworth

Sec. 1 Twp. 10 R. 20-E

Well No. #1 R. B. Kesinger Farm

Magnolia Company


(Leavenworth)

 Ft. from N. Line

660 Ft. from S. Line

660 Ft. from E. Line

 Ft. from W. Line

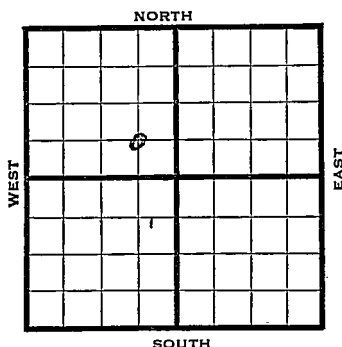

1942

REPORT

7/1 Machine.

7/8 Drlg. 380'

7/15 8" - 690' Drlg. 935'

7/22 Drlg. 1220'

7/29 Miss. 1383'

No shows.

T.D. 1470'

ABANDONED

Leavenworth KANSAS

Map No. MM Sec. 1 Twp. 10 R. 20EWell No. 1 R. B. KesingerMagnolia

Company

ABANDONED

Contractor

C SE NW

SECTION PLAT

	0		

Ft. from N. Line

660

Ft. from S. Line

660

Ft. from E. Line

Ft. from W. Line

ACKERLAND POOL

RECORD

Location

Cased _____ in., _____ ft.

Rig up

Sand _____

Drilling and Remarks:

Gas _____

Oil _____

Total Depth 1420

PRODUCTION

1st 24 hrs. Nat. _____

1st 24 hrs. after shot _____

Gas _____ Cu. Ft.

Dry Hole _____

Abandoned _____

Date

III 29 1942 19S. J. LEWIS Scout

Leavenworth **KANSAS**Map No. SM Sec. 1 Twp. 10 R. 20EWell No. 1 R. B. KesingerMagnolia CompanyFIRST REPORT Contractor

C S E N W

 Ft. from N. Line660 Ft. from S. Line660 Ft. from E. Line Ft. from W. Line

SECTION PLAT

	o		

Leavenworth Pool

RECORD

Location Cased in., ft.Rig up Sand

Drilling and Remarks:

Gas Oil Total Depth Machine

PRODUCTION

1st 24 hrs. Nat. 1st 24 hrs. after shot Gas Cu. Ft.Dry Hole Abandoned

Date

JUL 1 1942 19S. J. LEWIS

Scout