


Section 1 Township 10 Range 20-E

Well No. #2 Schmidt

Company M. Laughlin

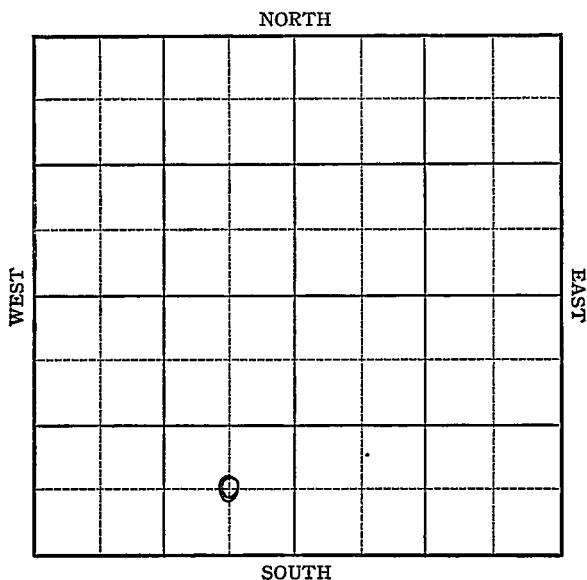

KANSAS

Leavenworth

Sec. 1 Twp. 10 R. 20-E

Well No. #2 Schmidt Farm

M. Laughlin Company


(Ackerland)

 Ft. from N. Line

660 Ft. from S. Line

660 Ft. from E. Line

 Ft. from W. Line

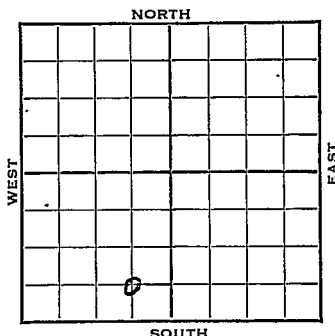

1942

REPORT

7/15	12" - 100' Drlg. 160'
7/22	8" - 735' Sand 1385-90' T.D. Run 6". S/gas.
7/29	6" - 1385 Miss. 1426' TD S.D.
8/5	T.D. 1450 PB 1425 1 M. Gas.
8/12	Sand 1385 Miss. 1426 T.D. 1450 P.B. 1425 6" - 1385 1,260,000 gas.

COMPLETED

Leavenworth KANSAS

Map No. NM Sec. 1 Twp. 10 R. 20EWell No. 2 SchmidtM. Laughlin Company

FIRST REPORT

Contractor

C SE SW

SECTION PLAT

	0		

_____ Ft. from N. Line

660 Ft. from S. Line660 Ft. from E. Line

_____ Ft. from W. Line

ACKERLAND POOL

Location _____

Rig up _____

Drilling and Remarks:

12" - 100'

Drlg. 160'

RECORD

Cased _____ in., _____ ft.

Sand _____

Gas _____

Oil _____

Total Depth _____

PRODUCTION

1st 24 hrs. Nat. _____

1st 24 hrs. after shot _____

Gas _____ Cu. Ft.

Dry Hole _____

-Abandoned _____

Date

JUL 15 1942

19

S. J. LEWIS

Scout

Map No. MM Sec. 1 Twp. 10 R. 20EWell No. 2 SchmidtMcLaughlin CompanyCOMPLETE Contractor

C SE SW

SECTION PLAT

	6		

 Ft. from N. Line660 Ft. from S. Line660 Ft. from E. Line Ft. from W. Line

ACHERLAND POOL

RECORD

Location Cased in., ft.Rig up Sand

Drilling and Remarks:

Gas Oil Total Depth 1450Sanol 1385Miss 1426PB 14256 " @ 13851260,000 Gas

PRODUCTION

1st 24 hrs. Nat. 1st 24 hrs. after shot Gas Cu. Ft.Dry Hole Abandoned

Date

AUG 1 2 1942 19S. J. LEWIS Scout