


KANSAS Leavenworth

Section 1 Township 10 Range 20-E

Well No. #1 Schmidt

Company McLaughlin

NORTH McLouth Pool

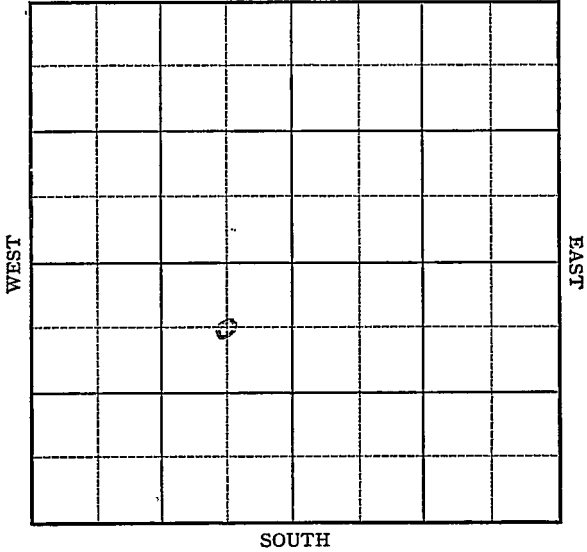

Sec. 1 Twp. 10 R. 20-E

Well No. #1 Schmidt Farm

McLaughlin Company

(McLouth)


660 Ft. from N. Line

_____ Ft. from S. Line

660 Ft. from E. Line

_____ Ft. from W. Line

Elev. 1042

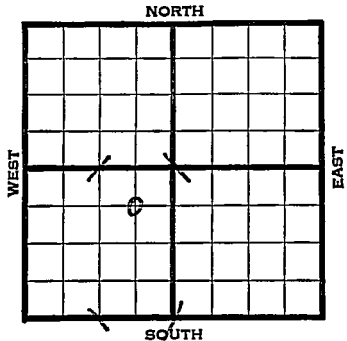

1942	REPORT
5/27	Machine.
6/3	Spud 80'
6/10	Drlg. 610'
6/17	8" - 805' T.D. 1040' Fsg.
6/24	" " "
7/1	6" - 1040' Drlg. 1345'
7/8	Sand 1382'
	5" - 1382'
	T.D. 1399'
	P.B. to 1392'
	3,240,000 cu. ft. gas.
	COMPLETED

KANSAS

Leavenworth

Map No. MM Sec. 1 Twp. 10 R. 20EWell No. 1 SchmidtMcLaughlin

Company

COMPLETED

Contractor

C N E S W

SECTION PLAT

630 Ft. from N. Line

_____ Ft. from S. Line

660 Ft. from E. Line

_____ Ft. from W. Line

	o		

ACKERLAND POOL

Location _____

Rig up _____

Drilling and Remarks:

Sand 13825" C 1382PB 13923,240,000 cu ft
Gas

RECORD

Cased _____ in., _____ ft.

Sand _____

Gas _____

Oil _____

Total Depth 1392

PRODUCTION

1st 24 hrs. Nat. _____

1st 24 hrs. after shot _____

Gas _____ Cu. Ft.

Dry Hole _____

Abandoned _____

Date

JUL 8 1942 19S. J. LEWIS

Scout

Leavenworth

Map No. MM Sec. 1 Twp. 10 R. 20E

Well No. 1 Schmidt

McLaughlin Company

FIRST REPORT

Contractor

C NE SW


SECTION PLAT

660 Ft. from N. Line

_____ Ft. from S. Line

660 Ft. from E. Line

_____ Ft. from W. Line

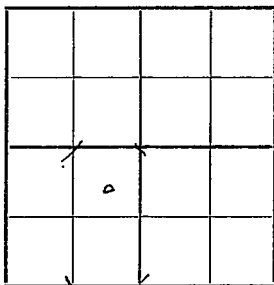

MCLOUTH POOL

RECORD

Location _____

Cased _____ in., _____ ft.

Rig up _____

Sand _____

Drilling and Remarks:

Gas _____

Oil _____

Total Depth _____

Machine

PRODUCTION

1st 24 hrs. Nat. _____

1st 24 hrs. after shot _____

Gas _____ Cu. Ft.

Dry Hole _____

Abandoned _____

Date

MAY 27 1942 19

S. J. LEWIS Scout