

Section 13 Township 10 Range 10-E


Well No. #1 Uhlig

Company Ben Brack

Sec. 13 Twp. KANSAS R. 10-E

Well No. #1 Uhlig Farm

Ben Brack Company

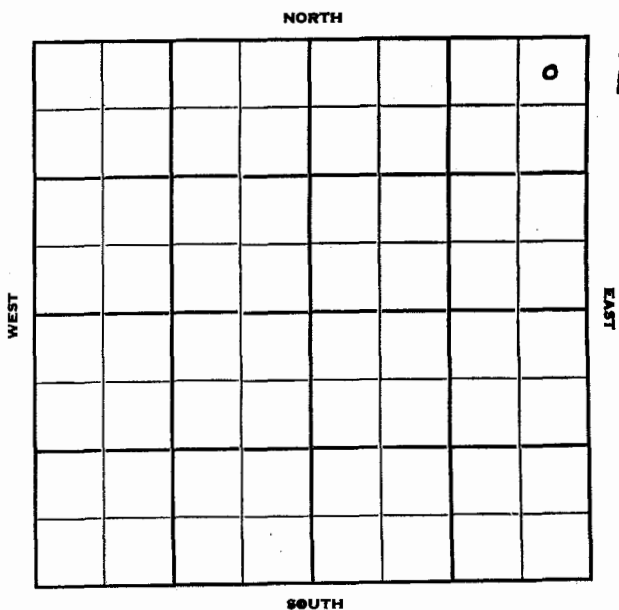

Wildcat


330 Ft. from N. Line

Ft. from S. Line

330 Ft. from E. Line

Ft. from W. Line

NE NE NE

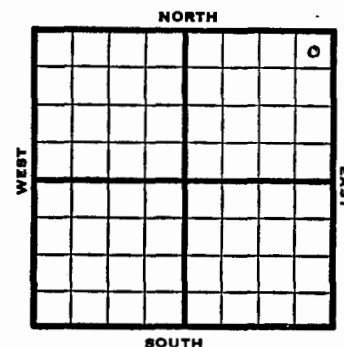

1950 Elev. 1071' REPORT

11/1 Drlg.

1951
1/3

Spud 11-15-50
D&A TD 3206
10-3/4" @ 170
Top 625' Lans. 1145
KC 1265 Marmaton 1472
Miss 2142' Kinderhook 2348'
Hunton 2551' Maq. 2915
Viola 2973 St. Peter 3105
Arb. 3193' TD 3206 D&A

ABANDONED

T +446
L -74
B&A
M -1071
T-M 1517
L-M 997
B&A-M

1071
625
446

1145
1071
74

2142
1071
1071

2142
625
1517

2142
1145
997

County Waubesaunsee State Kan.

Sec. 13 (Blk. Twp.) 10 (Sur. Rge.) 10E Map No.

Operator Ben Brack

Well No. 1 Farm Uhlrig

Elev. Location NE NE NE

330 Ft. From N Line NE

330 Ft. From E Line Quarter

1st. Report NOV 1 1950

Completion

Remarks

Spudding Date

Drig. Data Wildeat

Drig.

J. E. TYRA

[illegible]

Orig. Data	D & A	TD 3206
10 3/4" C 170	Top. 625	Lens. 1145
KC 1265	Marmaton 1472	Miss. 2142
Kinderhook 2348	Hunton 2551	Mag. 2915
Viola 2973	St. Peter 3105	Arb. 3193
TD 3206	D & A	

J. E. TYRA