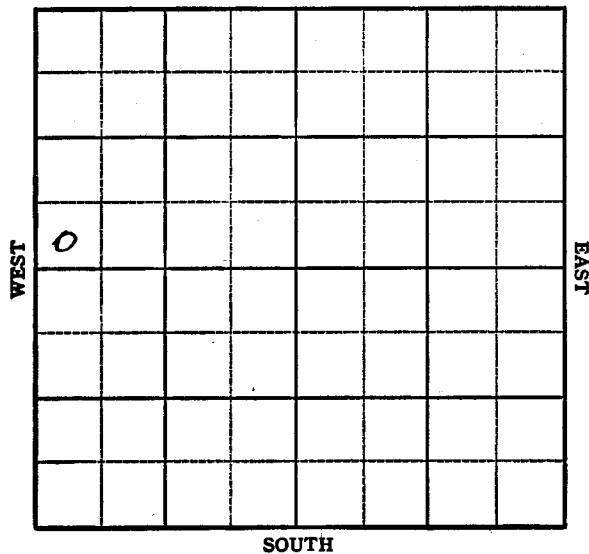


KANSAS Wabaunsee

Section 28 Township 10 Range 10EWell No. 1 MortonCompany Amerada**Wildcat**
NORTH

KANSAS Wabaunsee

Sec. 28 Twp. 10 R. 10EWell No. 1 Morton FarmAmerada Company**Wildcat**


Ft. from N. Line

330 Ft. from S. Line

Ft. from E. Line

330 Ft. from W. Line

SW NW

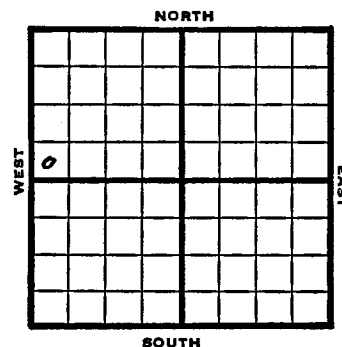

1948

REPORT

11/17 Drilling
 11/23 Spud
 11/30 "
 12/8 TD 2410'
 Aband.

ABANDONED

Map No. _____ Sec. 28 Twp. 10 R. 10EWell No. 1 MortonAmerada Company

FIRST REPORT

Contractor

SW NW

SECTION PLAT

o			

_____ Ft. from N. Line

330 Ft. from S. Line

_____ Ft. from E. Line

330 Ft. from W. Line

Wabaunsee County

Location _____

Rig up _____

Drilling and Remarks:

drlg.

RECORD

Cased _____ in., _____ ft.

Sand _____

Gas _____

Oil _____

Total Depth _____

PRODUCTION

1st 24 hrs. Nat. _____

1st 24 hrs. after shot _____

Gas _____ Cu. Ft.

Dry Hole _____

Abandoned _____

Date

NOV 17 1948 19S. J. LEWIS ScoutMap No. 104 Sec. 28 Twp. 10 R. 10EWell No. 1 MortonAmerada Company

ABANDONED

Contractor

SW NW

SECTION PLAT

o			

_____ Ft. from N. Line

330 Ft. from S. Line

_____ Ft. from E. Line

330 Ft. from W. Line

Wabaunsee County

Location _____

Rig up _____

Drilling and Remarks:

RECORD

Cased _____ in., _____ ft.

Sand _____

Gas _____

Oil _____

Total Depth 2410

PRODUCTION

1st 24 hrs. Nat. _____

1st 24 hrs. after shot _____

Gas _____ Cu. Ft.

Dry Hole _____

Abandoned _____

Date

DEC 8 1948 19S. J. LEWIS Scout