


Section 10 Township 10 Range 20E

Well No. #1 Lobb

Company Ed Jackson et al.

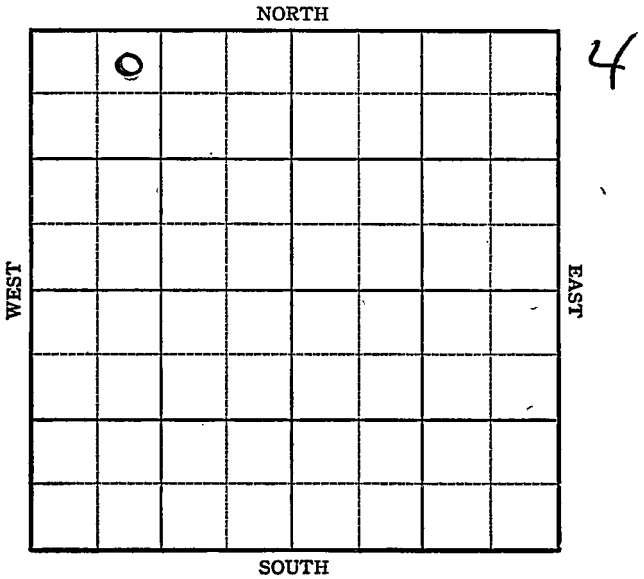

Sec. 10 Twp. 10 R. 20E

Well No. #1 Lobb Farm

ED Jackson et al. Company


McLouth

330 Ft. from N. Line

_____ Ft. from S. Line

_____ Ft. from E. Line

990 Ft. from W. Line

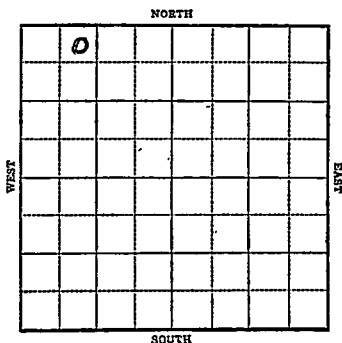

1944

R E P O R T

3/8 10" @ 18'
Drilling 800'

3/16 6" @ 1478
Miss 1474
Drilling 1552

3/22 Miss 1474
HFW
TD 1616

ABANDONED

KANSAS

Map No. MM Sec. 10 Twp. 10 R. 20EWell No. 1 LobbEd Jackson et al.

Company

FIRST REPORT

Contractor

NE NW NW

SECTION PLAT

330 Ft. from N. Line

_____ Ft. from S. Line

_____ Ft. from E. Line

990 Ft. from W. Line

McLouth Pool

Location _____

Rig up _____

Drilling and Remarks:

10" - 18'800'

RECORD

Cased _____ in. _____ ft.

Sand _____

Gas _____

Oil _____

Total Depth _____

PRODUCTION

1st 24 hrs. Nat. _____

1st 24 hrs. after shot _____

Gas _____ Cu. Ft.

Dry Hole _____

Abandoned _____

Date

MAR 8 1944 19

S. J. LEWIS Scout

Map No. VM Sec. 10 Twp. 10 R. 20E

Well No. 1 Lobb

Ed Jackson et al. Company

ABANDONED Contractor

NE NW NW

SECTION PLAT

330 Ft. from N. Line

_____ Ft. from S. Line

_____ Ft. from E. Line

990 Ft. from W. Line

o			

McLouth Pool

Location _____

Rig up _____

Drilling and Remarks:

Miss 1474
HFW.

RECORD

Cased _____ in., _____ ft.

Sand _____

Gas _____

Oil _____

Total Depth 1616

PRODUCTION

1st 24 hrs. Nat. _____

1st 24 hrs. after shot _____

Gas _____ Cu. Ft.

Dry Hole _____

Abandoned _____

Date

MAR 22 1944 19

S. J. LEWIS Scout