

KANSAS

Jefferson


15 087 60021 0000
FORM 51 5M 4-41 PETROL

Section 12 Township 10 Range 19-E

Well No. 1 Meyer

Company Whittan


NORTH Miscellaneous

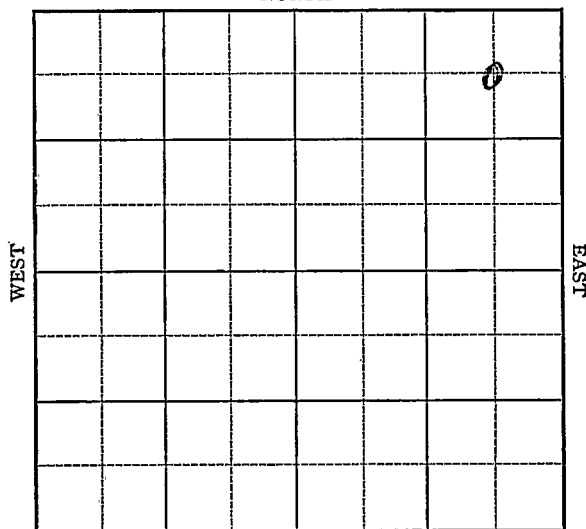

SOUTH

Sec. 12 Twp. 10 R. 19-EWell No. #1 Meyer FarmWhittan Company

(Misc.)

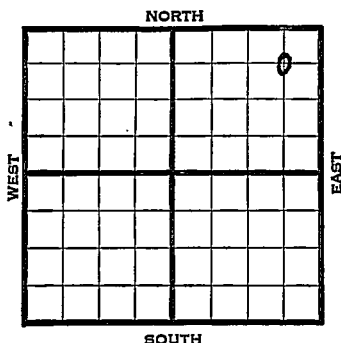660 Ft. from N. Line Ft. from S. Line660 Ft. from E. Line Ft. from W. Line

1941	REPORT
8/27	Machine - Spud.
9/11	SD 842'
9/18	"
9/25	10" - 130'
	SD 1065'
10/2	Sand 1512' Drlg. 1532'
10/9	T.D. 1540' SD.
10/16	8" - 1040' SD 1540'
10/23	" " " "
10/30	" " " "
11/6	" " " "
11/13	TD 1620' SD.
11/19	Miss. 1616'
	T.D. 1620'
	No shows.
	ABANDONED

Map No. _____ Sec. 12 Twp. 10 R. 19EWell No. 1 MeyerWhittan Company

Contractor

FIRST REPORT**SECTION PLAT**

C NE NE

660 Ft. from N. Line

_____ Ft. from S. Line

660 Ft. from E. Line

_____ Ft. from W. Line

			o

MISCELLANEOUS

Location _____

Rig up _____

Drilling and Remarks:

Machine Spud

RECORD

Cased _____ in., _____ ft.

Sand _____

Gas _____

Oil _____

Total Depth _____

PRODUCTION

1st 24 hrs. Nat. _____

1st 24 hrs. after shot _____

Gas _____ Cu. Ft.

Dry Hole _____

Abandoned _____

Date

AUG 27 1941 19 S. J. LEWIS Scout

QNT

CA 17

W. H. No.

Misc. Small Maps.....
 Cards.....
 Tracing.....
 France Map.....
 Scarborough Map.....
 Moody Map.....
 Geological Dept.
 Moody Plot Book

Date

Jefferson **KANSAS**Map No. NM Sec. 12 Twp. 10 R. 19EWell No. 1 MeyerWhitten CompanyABANDONED Contractor

C NE NE

SECTION PLAT

			0

660 Ft. from N. Line Ft. from S. Line660 Ft. from E. Line Ft. from W. Line

MISCELLANEOUS

RECORD

Location Cased in., ft.Rig up Sand

Drilling and Remarks:

Gas Oil Total Depth 1620

PRODUCTION

1st 24 hrs. Nat. 1st 24 hrs. after shot Gas Cu. Ft.Dry Hole Abandoned

Date

NOV 19 1941 19 S. J. LEWIS Scout*Miss 1616*
No s hole

Misc. Small Maps

Cards

Tracing

France Map

Scarborough Map

Moody Map

Geological Dept.

Moody Flat Book