


FORM 51 5M 10-41 PETROL

Section 12 Township 10 Range 20-E

Well No. #1 Williams

Company McNerney et al

NORTH Ackerman Pool

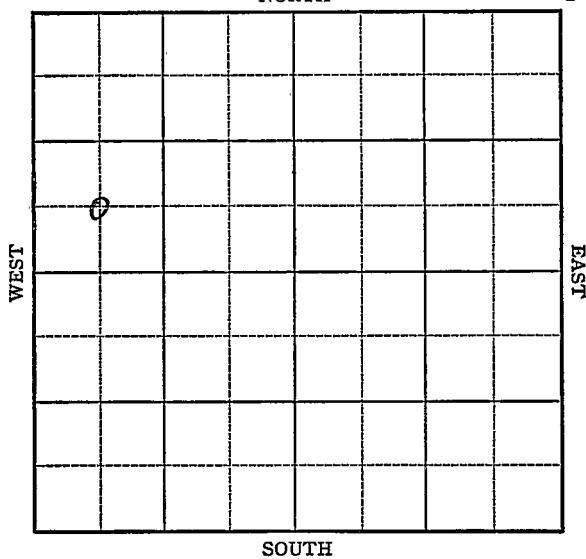

KANSAS

Leavenworth

Sec. 12 Twp. 10 R. 20-E

Well No. #1 Williams Farm

McNerney et al Company


(Ackerman)

 Ft. from N. Line

660 Ft. from S. Line

 Ft. from E. Line

660 Ft. from W. Line

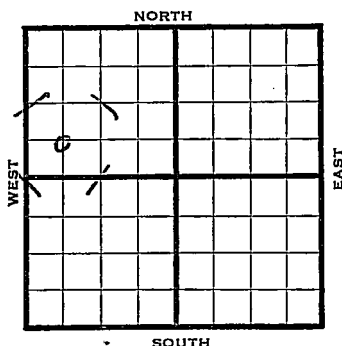

1942

REPORT

7/1 Machine.
7/8 8" - 690' Drlg. 700'

7/15 Miss. 1448'
T.D. 1474'
No shows.

ABANDONED


Leavenworth **KANSAS**Map No. MM Sec. 12 Twp. 10 R. 20EWell No. 1 WilliamsMcNerney et al. CompanyFIRST REPORT Contractor

C SW NW

 Ft. from N. Line660 Ft. from S. Line Ft. from E. Line660 Ft. from W. Line

Ackerman Pool

SECTION PLAT

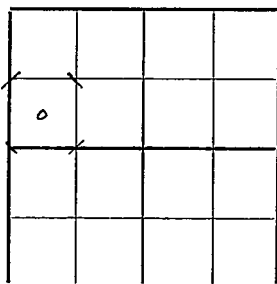Location Rig up

Drilling and Remarks:

Machine

RECORD

Cased in., ft.Sand Gas Oil Total Depth

PRODUCTION

1st 24 hrs. Nat. 1st 24 hrs. after shot Gas Cu. Ft.Dry Hole Abandoned

Date

JUL 1 1942 19 S. J. LEWIS Scout

Leavenworth

Map No. NM Sec. 12 Twp. 10 R. 20EWell No. 1 WilliamsMcNerney et al.

Company

ABANDONED

Contractor

C S W NW

SECTION PLAT

o			

Ft. from N. Line

660 Ft. from S. Line

Ft. from E. Line

660 Ft. from W. Line

ACKERLAND POOL

Location _____

Rig up _____

Drilling and Remarks:

Miss 1448No show

RECORD

Cased _____ in., _____ ft.

Sand _____

Gas _____

Oil _____

Total Depth 1424

PRODUCTION

1st 24 hrs. Nat. _____

1st 24 hrs. after shot _____

Gas _____ Cu. Ft.

Dry Hole _____

Abandoned _____

Date

JUL 15 1942 19S. J. LEWIS Scout