

KANSAS


Leavenworth

FORM 51 5M 4-41 PETROL

Section 12 Township 10 Range 20-E

Well No. #1 Watson

Company McLaughlin et al

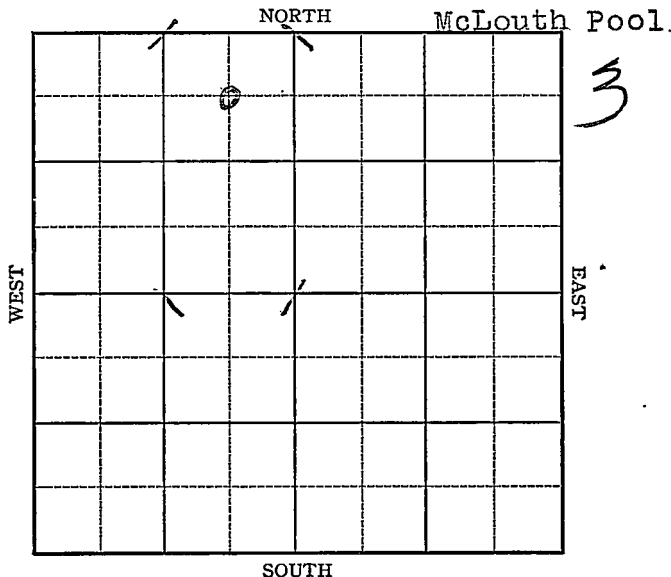

Sec. 12 Twp. 10 R. 20-E

Well No. #1 Watson Farm

McLaughlin et al Company

(McLouth)


660 Ft. from N. Line

_____ Ft. from S. Line

660 Ft. from E. Line

_____ Ft. from W. Line

Elev. 1034

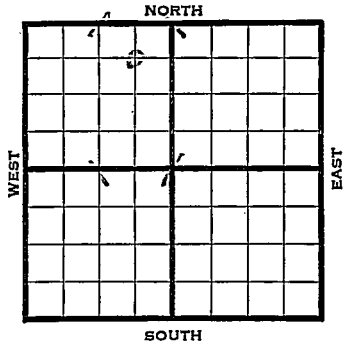

1942

REPORT

6/3	55' run 10".
6/10	Sand 1356-65' T.D. 5" - 1356' WOC.
6/17	Sand 1356'
	5" - 1356'
	T.D. 1365'
	3 M gas.

COMPLETED


Leavenworth KANSAS

Map No. MM Sec. 12 Twp. 10 R. 20EWell No. 1 WatsonMcLaughlin et al. CompanyFIRST REPORT Contractor

C NE NW

660 Ft. from N. Line Ft. from S. Line660 Ft. from E. Line Ft. from W. Line

SECTION PLAT

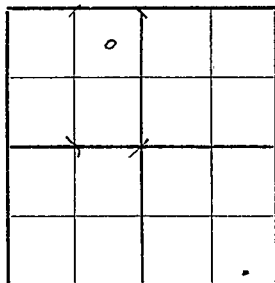

MCLOUTH POOL

Location Rig up

Drilling and Remarks:

55' Run 10"

RECORD

Cased in., ft.Sand Gas Oil Total Depth

PRODUCTION

1st 24 hrs. Nat. 1st 24 hrs. after shot Gas Cu. Ft.Dry Hole Abandoned

Date

JUN 3 1942 19S. J. LEWIS Scout

Leavenworth **KANSAS**

Map No. MM Sec. 12 Twp. 10 R. 20E

Well No. 1 Watson

McLaughlin et al. Company

COMPLETED

Contractor

C NE NW

SECTION PLAT

660 Ft. from N. Line

_____ Ft. from S. Line

660 Ft. from E. Line

_____ Ft. from W. Line

	o		

MCLOUTH POOL

Location _____

Rig up _____

Drilling and Remarks:

Sand 1356

5" @ 1356

3M Gas

RECORD

Cased _____ in., _____ ft.

Sand _____

Gas _____

Oil _____

Total Depth 1365

PRODUCTION

1st 24 hrs. Nat. _____

1st 24 hrs. after shot _____

Gas _____ Cu. Ft.

Dry Hole _____

Abandoned _____

Date

JUN 17 1942 19

S. J. LEWIS Scout