

KANSAS

Leavenworth


FORM 51 5M 4-41 PETROL

Section 12 Township 10 Range 20-E

Well No. #2 Watson

Company McLaughlin

NORTH McLouth Pool

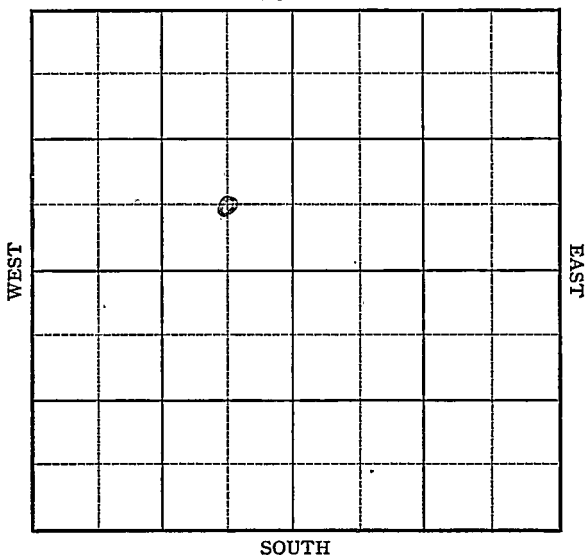

Sec. 12 Twp. 10 R. 20-E

Well No. #2 Watson Farm

McLaughlin Company.


(McLouth)

 Ft. from N. Line

660 Ft. from S. Line

660 Ft. from E. Line

 Ft. from W. Line

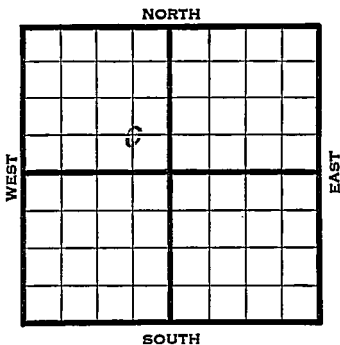

1942	REPORT
6/3	Location
6/10	"
6/17	"
6/24	"
7/1	"
7/8	"
7/15	"
7/22	"
7/29	"
8/5	"
8/12	"
8/19	Abandoned location
	ABANDONED

Leavenworth **KANSAS**

Map No. AM Sec. 12 Twp. 10 R. 20E

Well No. 2 Watson

McLaughlin Company

~~FIRST REPORT~~ Contractor

C SE NW

SECTION PLAT

	D		

_____ Ft. from N. Line

660 Ft. from S. Line

660 Ft. from E. Line

_____ Ft. from W. Line

MCCLOUTH POOL

Location XX

Rig up _____

Drilling and Remarks:

RECORD

Cased _____ in., _____ ft.

Sand _____

Gas _____

Oil _____

Total Depth _____

PRODUCTION

1st 24 hrs. Nat. _____

1st 24 hrs. after shot _____

Gas _____ Cu. Ft.

Dry Hole _____

Abandoned _____

Date

JUN 3 1942 19

S. J. LEWIS Scout

Map No. MM Sec. 12 Twp. 10 R. 20EWell No. 2 WatsonMcLaughlin

Company

ABANDONED

Contractor

C SE NW

SECTION PLAT

 Ft. from N. Line660 Ft. from S. Line660 Ft. from E. Line Ft. from W. Line

	o		

ACKERLAND POOLLocation Rig up:

Drilling and Remarks:

RECORD

Cased in., ft.Sand Gas Oil Total Depth

PRODUCTION

1st 24 hrs. Nat. 1st 24 hrs. after shot Gas Cu. Ft.Dry Hole Abandoned

Date

AUG 19 1942S. J. LEWIS Scout