


Section 13 Township 10 Range 10-E

Well No. #1 Uhlrig

Company Ben Brack

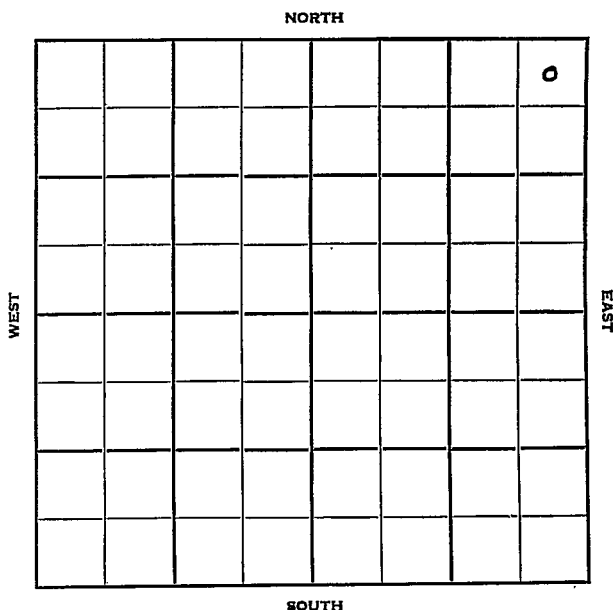

KANSAS

10-E

Sec. 13 Twp. 10 R. 10-E

Well No. #1 Uhlig Farm

Ben Brack

Company

Contractor

Wildcat

330

Ft. from N. Line


Ft. from S. Line

330

Ft. from E. Line

Ft. from W. Line

NE NE NE

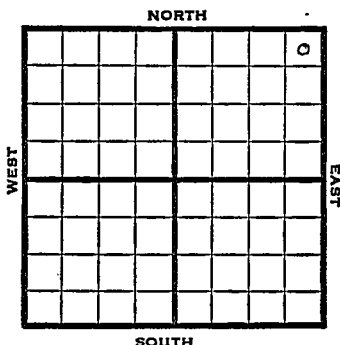

1950

Elev. 1071' REPORT

11/1

Drlg.

1951

1/3

Spud 11-15-50

D&A TD 3206

10-3/4" @ 170

Top 625' Lans. 1145

KC 1265 Marmaton 1472

Miss 2142' Kinderhook 2348'

Hunton 2551' Maq. 2915

Viola 2973 St. Peter 3105

Arb. 3193' TD 3206 D&A

ABANDONED

T +446

L -74

B&C

M -1071

T-M 1517

L-M 997

B&C-M


1071
625
446

1145
1071
74

2142
1071
1071

2142
625
1517

2142
1145
997

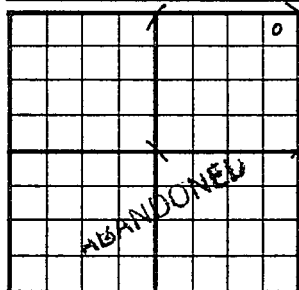County Waubaunsee State KansasSec. 13 (Blk.
Twp.) 10 (Sur.
Rge.) 10E Map No.Operator Ben BrackWell No. 1 Farm UhlrigElev. 1071 Location NE NE NE330 Ft. From N Line NE330 Ft. From E Line Quarter

1st. Report

Completion JAN 3 1951Remarks WildcatSpudding Date 11-15-50Drlg. Data D & A TD 320610 3/4" @ 170 Top. 625 Lans. 1145KC 1265 Marmaton 1472 Miss. 2142Kinderhook 2348 Hunton 2551 Maq. 2915Viola 2973 St. Peter 3105 Arb. 3193TD 3206 D & A

J. E. TYRA


County Waubaussee State KANSAS

Sec. 13 (Blk. Twp.) 10 (Sur. Rge.) 10E Map No.

Operator Ben Brack

Well No. 1 Farm Uhlrig

Elev. _____ Location NE NE NE

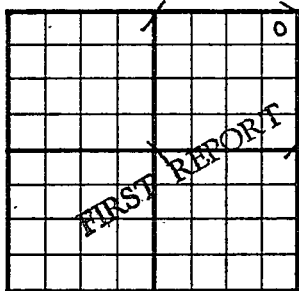

330 Ft. From N Line NE

330 Ft. From E Line Quarter

1st. Report NOV 1 1950

Completion _____

Remarks _____

Spudding Date _____

Drlg. Data Wildcat

drlg.

J. E. TYRA