

KANSAS


Map No. 103 Sec. 28 Twp. 10 R. 15EWell No. 1 Federal Land Bank

C. W. Murchinson Company

FIRST REPORT Contractor

SE/C

SECTION PLAT

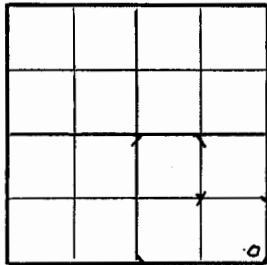

Ft. from N. Line

330 Ft. from S. Line330 Ft. from E. Line

Ft. from W. Line

WILDCAT

Location

Rig up

Drilling and Remarks:

Cable

RECORD

Cased in, ft.

Sand

Gas

Oil

Total Depth

PRODUCTION

1st 24 hrs. Nat.

1st 24 hrs. after shot

Gas Cu. Ft.

Dry Hole

Abandoned

Date

JUN 2 1943 19 S. J. LEWIS Scout

KANSAS


Map No. 103 Sec. 28 Twp. 10 R. 15EWell No. 1 Federal Land Bank

C. W. Murdhnison Company

ABANDONED Contractor

SE/C

SECTION PLAT

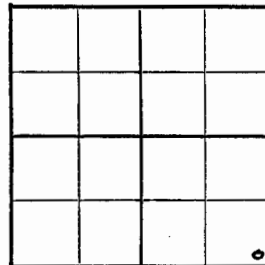

Ft. from N. Line

330 Ft. from S. Line330 Ft. from E. Line

Ft. from W. Line

WILDCAT

Location

Rig up

Drilling and Remarks:

Topeka 240

Leave 82.3

Hill 1983

Hua ton 2347


AL 2865

RECORD

Cased in, ft.

Sand

Gas

Oil

Total Depth 2885

PRODUCTION

1st 24 hrs. Nat.

1st 24 hrs. after shot

Gas Cu. Ft.

Dry Hole

Abandoned

Date

AUG 1 1 1943 19 S. J. LEWIS Scout

473723

no wall

no wall

Misc. Small Maps	<i>No Small map Area</i>
Cards	<i>Madge</i>
Tracing	<i>Madge</i>
France Map	<i>✓</i>
Scarborough Map	<i>✓</i>
Moody Map	<i>✓</i>
Geological Dept.	
Moody Flat Book	

Misc. Small Maps	<i>No Small map Area</i>
Cards	<i>Madge</i>
Tracing	<i>Madge</i>
France Map	<i>✓</i>
Scarborough Map	<i>✓</i>
Moody Map	<i>✓</i>
Geological Dept.	
Moody Flat Book	

KANSAS

Shawnee


Sec. 28 Twp. 10 R. 15-EWell No. #1 Federal Land Bank FarmC. W. Murchinson Company

Wildcat

Ft. from N. Line

330 Ft. from S. Line330 Ft. from E. Line

Ft. from W. Line

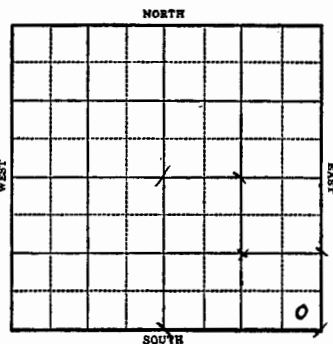

1943 El. 1058 REPORT

3/2 Cable Rig
 6/9 " "
 3/16 195' fsg
 3/23 Drlg. 776'
 3/30 Drlg. 813'
 7/7 Drlg. 1500'
 /15 1500' S
 /21 200' Run 5"
 /28 No report.
 3/4 Drlg. 2864'
 3/11 Topeka 240
 Lans 323
 Miss 1983
 Hunton 2347
 St Peters 2735
 Ard 2865
 T.D. 2885'

ABANDONED

KANSAS

Shawnee

FORM 51 5M 1-42 PETROL

Section 28 Township 10 Range 15-EWell No. #1 Federal Land BankCompany C. W. Murchinson