


Map No. **KANSAS** Sec. 28 Twp. 10 R. 15^E
Well No. 1 - Ansherdum Farm
Jen Kins & Scott Company

NORTH

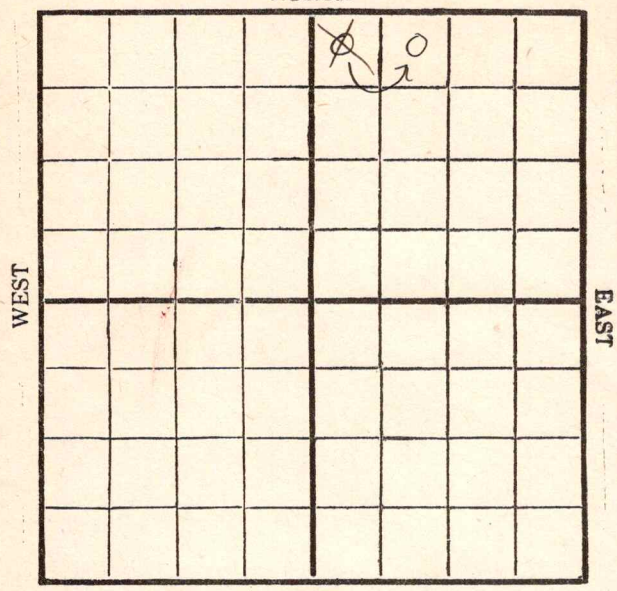

SOUTH

Location _____
Drilling Remarks _____

Rig Up _____
Drilling Remarks _____

RECORD

Cased _____ in. _____ ft.
Sand _____
Gas _____
Oil _____
Total Depth _____

PRODUCTION

1st 24 hrs. Nat. _____
1st 24 hrs. after shot _____
Gas _____ cu. ft. _____
Dry Hole _____
Abandoned _____

Map No. **KANSAS** Sec. 28 Twp. 10 R. 15E
 Well No. 1 - Aushraun Farm
Jenkins & Scott Company


330 Ft. from N. Line

_____ Ft. from S. Line

_____ Ft. from E. Line

990
~~330~~ Ft. from W. Line

1929

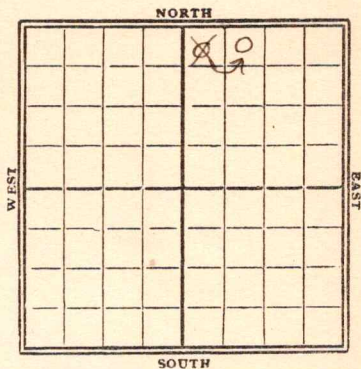

Date	REPORT
8/21	ROC
8/28	Wlg 1100'
9/4	SD 1100'
9/11	— 1/22 — 6/4 —
9/18	— 1/29 — 6/11 —
9/25	— 2/4 — 6/18
10/2	— 2/11 — T.D. 1100
10/9	— 2/9 — Abandon
10/16	— 2/26 —
10/23	— 3/5 —
10/30	— 3/12 —
11/6	— 3/19 —
11/13	— 3/26 —
11/20	— 4/2 —
11/27	— 4/9 —
12/3	— 4/16 —
12/11	— 4/23 —
12/23	— 4/30 —
12/30	— 5/7 —
1930	— 5/14 —
1/8	— 5/21 —
1/15	— 5/28 —

Shawnee
 105 **KANSAS** Sec. 28 Twp. 10 R. 15 E
 Well No. 1 Ansheraum
 Jenkins & Scott Company
 Contractor

CORRECTION**SECTION PLAT**

330 Ft. from N. Line
 _____ Ft. from S. Line
 _____ Ft. from E. Line
 990 Ft. from W. Line

		29	

Location _____

Rig up _____

Drilling and Remarks:

chy location

RECORD

Cased _____ in., _____ ft.

Sand _____

Gas _____

Oil _____

Total Depth _____

PRODUCTION

1st 24 hrs. Nat. _____

1st 24 hrs. after shot _____

Gas _____ Cu. Ft.

Dry Hole _____

Abandoned _____

Date

SEP 11 1929

CHAS. L. SHERWOOD

192

Scout

no wall up
no
Sinner

Returned	JD
Cards	
Tracing	CRK
France Map	nomaf
Scarborough Map	X
Moody Map	
Scarborough Plat Book	
Moody Plat Book	

105- **KANSAS** *Shawnee*
 Map No. _____ Sec. *28* Twp. *10* R. *15* ^E

Well No. *1*
Jenkins & Scott Company

Contractor

FIRST REPORTS**SECTION PLAT**

330 Ft. from N. Line

_____ Ft. from S. Line

_____ Ft. from E. Line

330 Ft. from W. Line

		0	

Location _____

Rig up _____

Drilling and Remarks:

Boys

RECORD

Cased _____ in., _____ ft.

Sand _____

Gas _____

Oil _____

Total Depth _____

PRODUCTION

1st 24 hrs. Nat. _____

1st 24 hrs. after shot _____

Gas _____ Cu. Ft.

Dry Hole _____

Abandoned _____

Date

8/21

19 *29*

CHAS. L. SHERWOOD

Scout

Map No. **KANSAS** Sec. 28 Twp. 10 R. 15E

105
Well No. 1 Ausheraum

Jenkins & Scott Company

Contractor

SECTION PLAT

		0	

330 Ft. from N. Line

_____ Ft. from S. Line

_____ Ft. from E. Line

990 Ft. from W. Line

ABANDONED

Location _____

Rig up _____

Drilling and Remarks:

RECORD

Cased _____ in., _____ ft.

Sand _____

Gas _____

Oil _____

Total Depth 1100

PRODUCTION

1st 24 hrs. Nat. _____

1st 24 hrs. after shot _____

Gas _____ Cu. Ft.

Dry Hole ☒

Abandoned ☒

Date

JUN 18 1930

CHAS. L. SHERWOOD

19

Scout