

15 10 3 00020 0000 Leavenworth


FORM 51 5M 10-41 PETROL

KANSAS

Section 15 Township 10 Range 20-E

Well No. #1 Wilkins

Company McLaughlin eta.

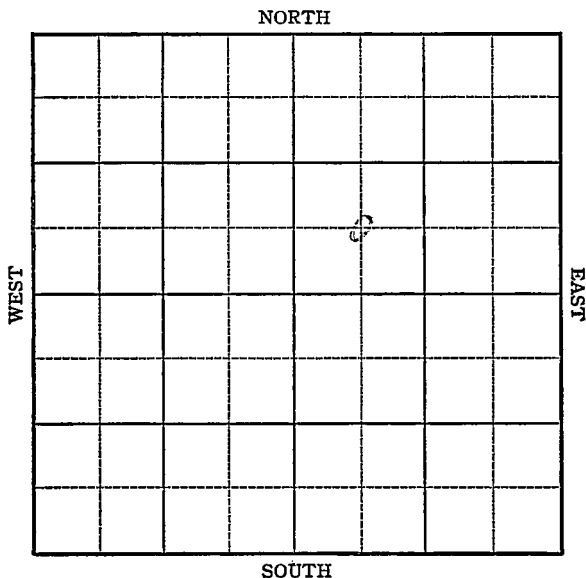

Sec. 15 Twp. 10 R. 20-E

Well No. #1 Wilkins Farm

McLaughlin et al Company


(Misc.)

 Ft. from N. Line

660 Ft. from S. Line

 Ft. from E. Line

660 Ft. from W. Line

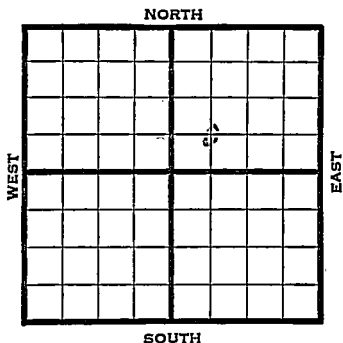

REPORT

1947

11/19 Location

11/26 Spud.

12/4 Drlg. 585'

12/11 8" @ 850 Drlg. 1195

12/18 Miss 1460 5" @ 1465 CD

12/23 Miss. 1460'

5" - 1465'

T.D. 1575'

H.F.W.

ABANDONED

Map No. MM Sec. 15 Twp. 10 R. 20E

Well No. 1 Wilkins

McLaughlin etal. Company

FIRST REPORT Contractor

C SN NE

_____ Ft. from N. Line

660 Ft. from S. Line

_____ Ft. from E. Line

660 Ft. from W. Line

SECTION PLAT

		△	

MISCELLANEOUS

Location XX

Rig up _____

Drilling and Remarks:

RECORD

Cased _____ in., _____ ft.

Sand _____

Gas _____

Oil _____

Total Depth _____

PRODUCTION

1st 24 hrs. Nat. _____

1st 24 hrs. after shot _____

Gas _____ Cu. Ft.

Dry Hole _____

Abandoned _____

Date

NOV 1 9 1941 19

S. J. LEWIS Scout

