


Leary Co

Map No. Kansas Sec. 16 Twp. 10 R. 5E

Well No. 1 Fawley Farm
Dr. Brunerley et al Company

NORTH

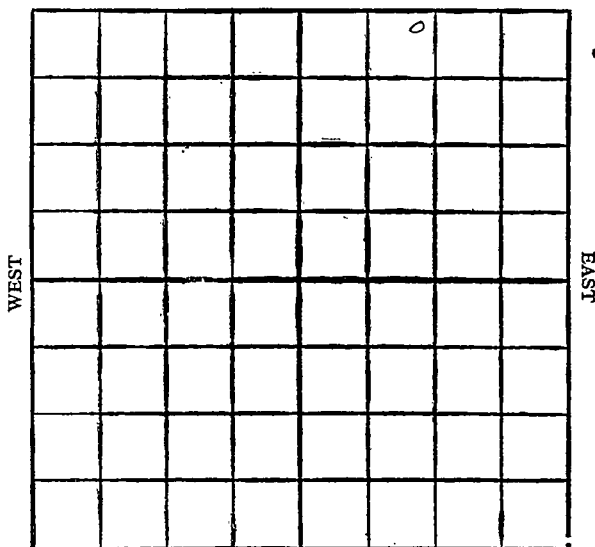

SOUTH

285 1193

Location

Drilling Remarks

Rig Up

Drilling Remarks

RECORD

Cased in. ft.

Sand

Gas

Oil

Total Depth

PRODUCTION

1st 24 hrs. Nat.

1st 24 hrs. after shot

Gas cu. ft.

Dry Hole

Abandoned

Geary Co


Map No. Kansas Sec. 16 Twp. 10 R. 5^EWell No. 1 Fawley FarmDr. Brunkley et al Company

NORTH

330 Ft. from N. Line

_____ Ft. from S. Line

_____ Ft. from E. Line

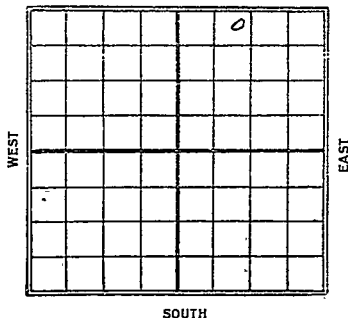990 Ft. from W. Line

Date	REPORT
1927	
5/11	Rig up
5/18	Rig
5/25	Spudding
6/1	
6/7	slg 1440'
6/15	S.D. 1440
6/22	Setting 6" - 2000
6/29	Set 6" - 2000 - S.D.
7/7	set 6" - 2000 - S.D.
7/13	
7/20	Drlg 2105
7/28	Chat 1900-1930 - S.D. 2310-
8/4	Chat 1900-1930
	Drlg 2321'
8/10	Drlg 2550-
8/18	S.D. 2550'
8/24	— 10/19 —
9/1	— 11/23 —
9/7	— 11/30 —
9/14	— 12/7 —
9/29	— 12/14 - D. & A. 2550
10/6	—
10/12	—

10/27 - Chat 1900-1930
S.D. 2550

11/2 —
11/9 —
11/16 —
11/23 —
11/30 —
12/7 —

no map
KANSASMap No. _____ Sec. 16 Twp. 10 R. 5 ^EWell No. 1 Lawley
Dr. Brincley et al Company

Contractor

FIRST REPORTS**SECTION PLAT**

		0	

330 Ft. from N. Line

_____ Ft. from S. Line

_____ Ft. from E. Line

990 Ft. from W. Line

Location _____

Rig up ☒ _____

Drilling and Remarks:

RECORD

Cased _____ in., _____ ft.

Sand _____

Gas _____

Oil _____

Total Depth _____

PRODUCTION

1st 24 hrs. Nat. _____

1st 24 hrs. after shot _____

Gas _____ Cu. Ft.

Dry Hole _____

Abandoned _____

Date

MAY 11 1927

CHAS. L. SHERWOOD

192

Scout

12. 7. 2013

None

Moody Flat Book

10. 11. 12. 

Small map

NO. 11711

no small map

no map
 KANSAS
 Map No. _____ Sec. *16* Twp. *10* R. *5*
 Well No. *1* *Lawley*
Dr. Brinckley Company
 Contractor

COMPLETED

SECTION PLAT

330

Ft. from N. Line

Ft. from S. Line

Ft. from E. Line

990

Ft. from W. Line

ABANDONED

| | | | |
|--|--|----------|--|
| | | <i>0</i> | |
| | | | |
| | | | |
| | | | |
| | | | |

Location _____

Rig up _____

Drilling and Remarks:

*Chat. 1900-1930**2550*

RECORD

Cased _____ in., _____ ft.

Sand _____

Gas _____

Oil _____

Total Depth *2550*

PRODUCTION

1st 24 hrs. Nat. _____

1st 24 hrs. after shot _____

Gas _____ Cu. Ft.

Dry Hole ☒Abandoned ☒

Date

DEC 14 1927

CHAS. L. SHERWOOD
Scout

No Wall Map

No Small Map

Returned.....

Birds.....

Going.....

France Map.....

Scarborough Map.....

Moody Map.....

Scarborough Flat Book.....

Moody Flat Book.....