

15 087 00002 0070

FORM SI 5M BRXA


KANSAS

Jefferson

Section 17 Township 10 Range 20E

Well No. #1 Bank of McLouth

Company Dan McLaughlin

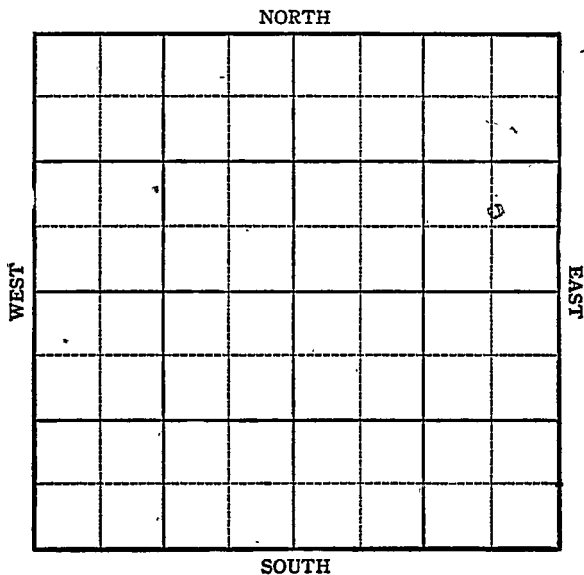

KANSAS

Jefferson County

Sec. 17 Twp. 10 R. 20E

Well No. #1 Bank of McLouth Farm

Dan McLaughlin Company

McLouth

NORTH

 Ft. from N. Line


800 Ft. from S. Line

600 Ft. from E. Line

 Ft. from W. Line

WEST

EAST

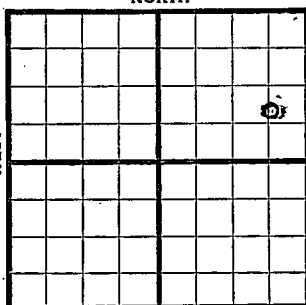

SOUTH

C N L S E N E

1944

1161 REPORT

8/16	Spud
8/23	Drlg. 270
8/30	Drlg. 550'
9/8	" "
9/13	" "
9/21	Drlg. 1580
	10" @ 103
9/28	" " " "
10/4	Miss 1580
	7" @ 1580
	Drlg. 1650
10/11	" " " "
10/18	Miss 1580
	7" @ 1580
	TD 1724

ABANDONED

Pool Name McLouth

KANSAS
 Map No. N 17 Sec. 17 Twp. 10 R. 20E

Well No. 1 Bank of McLouth
Dan McLaughlin Company
FIRST REPORT

Contractor

C N L SE NE

SECTION PLAT Ft. from N. Line800 Ft. from S. Line600 Ft. from E. Line Ft. from W. Line

			a

Jefferson

Location Rig up

Drilling and Remarks:

Spud

RECORDCased in., ft.Sand Gas Oil Total Depth **PRODUCTION**1st 24 hrs. Nat. 1st 24 hrs. after shot Gas Cu. Ft.Dry Hole Abandoned

Date

AUG 16 1944 19S. J. LEWIS Scout

Pool Name McLouthMap No. KANSAS Sec. 17 Twp. 10 R. 20 EWell No. 1 Bank of McLouthDan McLaughlin

Company

ABANDONED

Contractor

C N L S E N E

SECTION PLAT

			o

Ft. from N. Line

800

Ft. from S. Line

600

Ft. from E. Line

Ft. from W. Line

Jefferson

RECORD

Location

Cased _____ in., _____ ft.

Rig up

Sand _____

Drilling and Remarks:

Gas _____

Oil _____

Total Depth 172.4

PRODUCTION

1st 24 hrs. Nat. _____

1st 24 hrs. after shot _____

Gas _____ Cu. Ft.

Dry Hole _____

Abandoned _____

Date

OCT 1 8 1944

19

S. J. LEWIS

Scout