



STATE CORPORATION COMMISSION OF KANSAS
OIL & GAS CONSERVATION DIVISION
WELL COMPLETION OR RECOMPLETION FORM
AGO-1 WELL HISTORY
DESCRIPTION OF WELL AND LEASE

Operator: License # ... 9159
Name ... Sterling Exploration
Address ... 12101 Frost
City/State/Zip ... K.C. Mo. 64138

Purchaser...Vanguard Pipeline.....
.....

Operator Contact Person .James Reese.....
Phone .8167371026.....

Contractor: License # 5661
Name Kelly X. Down Drilling

Wellsite Geologist.....None.....
Phone.....

Designate Type of Completion

XX New Well Re-Entry Workover

Oil	SWD	Temp Abd
Gas	Inj	Delayed Comp.
Dry	Other (Core, Water Supply etc.)	

If ~~OWWO~~: old well info as follows:

```
Operator .....
Well Name .....
Comp. Date .....Old Total Depth.....
```

WELL HISTORY

Drilling Method:

XX Mud Rotary Air Rotary Cable

12-17-87	12-23-87	12-29-87
Spud Date	Date Reached TD	Completion Date

...1608....	..1605.....
Total Depth	PBTD

Amount of Surface Pipe Set and Cemented at 44 feet
Multiple Stage Cementing Collar Used? XX Yes XX No
If yes, show depth set.....feet
If alternate 2 completion, cement circulated
from surface feet depth to 1605 w/ 238 SX cmt
Cement Company Name Consolidated
Invoice # paid on location

API NO. 15-087-20,399.....
County.....Jefferson.....
.....NE.....Sec.1.....Twp.10.....Rge.19.....XX East
.....West

...⁴⁴²⁰... Ft North from Southeast Corner of Section
 ...⁴³⁰... Ft West from Southeast Corner of Section
 (Note: Locate well in section plat below)


Lease Name...W. Kimmel.....Well #...1-87

Field Name.....McLouth.....

Producing Formation.....Cherokee.....

Elevation: Ground.....N/A.....KB.....N/A.....

Section Plot

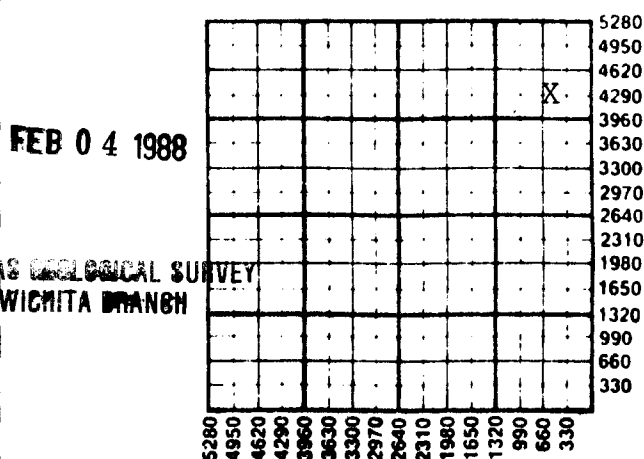

WATER SUPPLY INFORMATION

Disposition of Produced Water: _____ Disposal
Docket # _____ Repressuring

Questions on this portion of the ACO-1 call:

Water Resources Board (913) 296-3717

Source of Water:

Division of Water Resources Permit #.....

Groundwater.....Ft North from Southeast Corner
(Well)Ft West from Southeast Corner of
Sec Twp Rge East West

Surface Water.....Ft North from Southeast Corner
(Stream, pond etc).....Ft West from Southeast Corner

Sec	Twp	Rge	East	West
-----	-----	-----	------	------

XX Other (explain) McLouth.....
(purchased from city, R.W.D. #)

INSTRUCTIONS: This form shall be completed in triplicate and filed with the Kansas Corporation Commission, 200 Colorado Derby Building, Wichita, Kansas 67202, within 120 days of the spud date of any well. Rule 82-3-130, 82-3-107 and 82-3-106 apply.

Information on slide two of this form will be held confidential for a period of 12 months if requested in writing and submitted with the form. See rule 82-3-107 for confidentiality in excess of 12 months.

One copy of all wireline logs and drillers time log shall be attached with this form. Submit QP-4 form with

1-10-19E

SIDE TWO

Operator Name Sterling Exploration Lease Name W. Kimmel Well #... 1-87

Sec. 1 Township 10 Range 19 ☒ East ☐ West County Jefferson

Oil	Gas	Water	Gas-Oil Ratio	Gravity
Estimated Production Per 24 Hours	Bbls 220 MCF	None Bbls	CFPB	

METHOD OF COMPLETION

Production Interval

Disposition of gas: ☐ Vented ☒ Sold

☐ Open Hole ☒ Perforation ☐ Other (Specify)

..1557-1560..

Drill Stem Tests Taken ☐ Yes ☒ No
Samples Sent to Geological Survey ☐ Yes ☒ No
Cores Taken ☐ Yes ☒ No

Formation Description

☒ Log ☐ Sample

Name Top Bottom

No logs or samples above 600'

Kansas City Gp.	637	855
Pleasanton Gp	855	988
Marmaton Gp	988	1090
Cherokee	1090	1557
McLouth	1557	1586
Mississippian	1586	1608
TD	1608	

CASING RECORD ☐ New ☒ Used

Report all strings set-conductor, surface, intermediate, production, etc.

Purpose of String	Size Hole Drilled	Size Casing Set (In O.D.)	Weight Lbs/Ft.	Setting Depth	Type of Cement	#Sacks Used	Type and Percent Additives
surface casing	12 1/4	7 5/8	10.5	44	Port	20	None
	6 1/2	4 1/2		1605		238	2% Gel

PERFORATION RECORD

Acid, Fracture, Shot, Cement Squeeze Record

Shots Per Foot	Specify Footage of Each Interval Perforated	(Amount and Kind of Material Used)	Depth
3	1557-1560 3 1/8 SSB	N/A	

TUBING RECORD	Size	Set At	Packer at	Liner Run	☐ Yes ☒ No
---------------	------	--------	-----------	-----------	---

Date of First Production	Producing Method
	☒ Flowing ☐ Pumping ☐ Gas Lift ☐ Other (explain).....