SIDE ONE

12-10-19E

STATE CORPORATION COMMISSION OF KANSAS
OIL & GAS CONSERVATION DIVISION
WELL COMPLETION OR RECOMPLETION FORM
ACO-1 WELL HISTORY
DESCRIPTION OF WELL AND LEASE

API NO. 15-.087-20,081

County JEFFERSON

NE¼ Sec. 12 Twp. 10 Rge. 19 X East ___ West

4290 Ft North from Southeast Corner of Section
330 Ft West from Southeast Corner of Section
(Note: Locate well in section plat below)

Operator: License # 6192
Name N. R. HAMM CONTRACTOR INC
Address BOX 17
City/State/Zip PERRY, KS 66073

Purchaser NONE

Operator Contact Person N. RODNEY HAMM
Phone 913-597-5111

Contractor: License # 6193
Name HAMM DRILLING INC

Wellsite Geologist NONE
Phone

Lease Name BUDY Well # 1

Field Name MCLOUTH

Producing Formation

Elevation: Ground KB

Section Plat

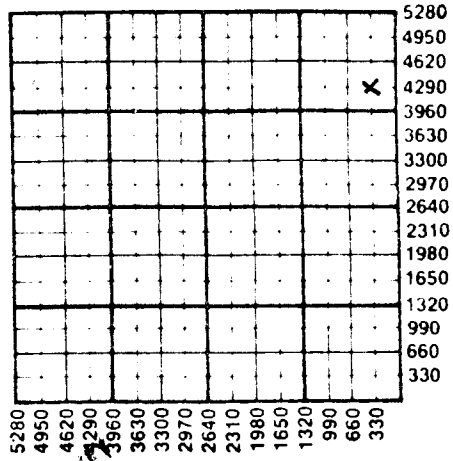

Designate Type of Completion
X New Well ___ Re-Entry ___ Workover

X Oil ___ SWD ___ Temp Abd
X Gas ___ Inj ___ Delayed Comp.
X Dry ___ Other (Core, Water Supply etc.)

If OWWO: old well info as follows:
Operator
Well Name
Comp. Date Old Total Depth

WELL HISTORY

Drilling Method:
X Mud Rotary ___ Air Rotary ___ Cable

5-21-84 | 5-24-84 | NONE 5-24-84
Spud Date | Date Reached TD | Completion Date

1605 |
Total Depth | PBTD

Amount of Surface Pipe Set and Cemented at 275 feet
Multiple Stage Cementing Collar Used? ___ Yes X No
If yes, show depth set feet
If alternate 2 completion, cement circulated
from feet depth to w/ SX cmt
Cement Company Name
Invoice #

X WATER SUPPLY INFORMATION
Disposition of Produced Water: ___ Disposal
Docket # ___ Repressuring

Questions on this portion of the ACO-1 call:
Water Resources Board (913) 296-3717
Source of Water:
Division of Water Resources Permit #

___ Groundwater Ft North from Southeast Corner
(Well) Ft West from Southeast Corner of
Sec Twp Rge ___ East ___ West

___ Surface Water Ft North from Southeast Corner
(Stream, pond etc) Ft West from Southeast Corner
Sec Twp Rge ___ East ___ West

___ Other (explain)
(purchased from city, R.W.D. #)

AUG 08 1985
KANSAS GEOLOGICAL SURVEY
WICHITA BRANCH

INSTRUCTIONS: This form shall be completed in triplicate and filed with the Kansas Corporation Commission, 200 Colorado Derby Building, Wichita, Kansas 67202, within 120 days of the spud date of any well. Rule 82-3-130, 82-3-107 and 82-3-106 apply.
Information on side two of this form will be held confidential for a period of 12 months if requested in writing and submitted with the form. See rule 82-3-107 for confidentiality in excess of 12 months.
One copy of all wireline logs and drillers time log shall be attached with this form. Submit CP-4 form with all plugged wells. Submit CP-111 form with all temporarily abandoned wells.

SIDE TWO

Operator Name N.R. Hamm Contr. Inc. Lease Name BUDY Well # 1

Sec. 12 Twp. 10 Rge. 19 ☒ East ☐ West County JEFFERSON

WELL LOG

INSTRUCTIONS: Show important tops and base of formations penetrated. Detail all cores. Report all drill stem tests giving interval tested, time tool open and closed, flowing and shut-in pressures, whether shut-in pressure reached static level, hydrostatic pressures, bottom hole temperature, fluid recovery, and flow rates if gas to surface during test. Attach extra sheet if more space is needed. Attach copy of log.

Drill Stem Tests Taken ☐ Yes ☒ No
Samples Sent to Geological Survey ☐ Yes ☒ No
Cores Taken ☐ Yes ☒ No

Formation Description
☒ Log ☐ Sample

Name	Top	Bottom
NO SAND FOUND		

AUG 08 1986
KANSAS GEOLOGICAL SURVEY
WICHITA BRANCH

CASING RECORD ☒ New ☐ Used
Report all strings set-conductor, surface, intermediate, production, etc.

Purpose of String	Size Hole Drilled	Size Casing Set (in O.D.)	Weight Lbs/Ft.	Setting Depth	Type of Cement	#Sacks Used	Type and Percent Additives
Surface	12¼	8⅝	22	200	Class A	150	3% Cal

PERFORATION RECORD

Shots Per Foot	Specify Footage of Each Interval Perforated

Acid, Fracture, Shot, Cement Squeeze Record

(Amount and Kind of Material Used)	Depth

TUBING RECORD Size — Set At — Packer at —

Liner Run ☐ Yes ☐ No

Date of First Production

Producing Method ☐ Flowing ☐ Pumping ☐ Gas Lift ☐ Other (explain)