


Map No. KANSAS Sec. 19 Twp. 10 R. 3^E
 Well No. 1-1-1 McMuller Farm
Derby Oil Company

NORTH

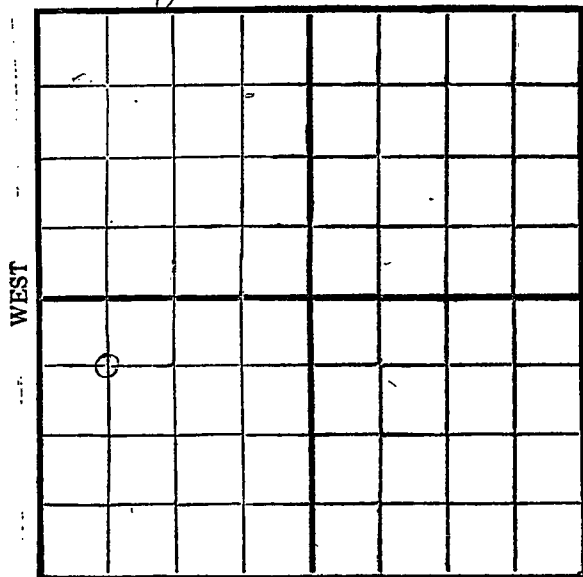

SOUTH

Location _____

Drilling Remarks _____

Rig Up _____

Drilling Remarks _____

RECORD

Cased _____ in. _____ ft.

Sand _____

Gas _____

Oil _____

Total Depth _____

PRODUCTION

1st 24 hrs. Nat. _____

1st 24 hrs. after shot _____


Gas _____ cu. ft. _____

Dry Hole _____

Abandoned _____

Map No. 19 Sec. 10 Twp. 3E
 Well No. 1- Niemuller Farm
Derby Oil Co Company

660 Ft. from N. Line
 _____ Ft. from S. Line
 _____ Ft. from E. Line
660 Ft. from W. Line

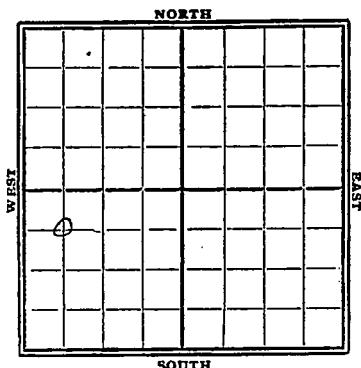

1929

Date

REPORT

7/17	Location
7/24	Rig
7/31	—
8/7	—
8/14	Drly 565'
8/21	" 1000
8/28	" 2200
9/4	SID 2200'
9/11	—
9/18	—
9/25	—
10/2	—
10/9	—
10/16	—
10/23	—
10/30	—
11/6	UFR at 2800'
11/13	Drly 2835'
11/20	No report
11/27	Drly 2850'
12/4	SID 3049'
12/11	—

12/23- HFW 3090-3100'

SD. 3110'

12/30 —

1930

1/7- HFW 3090-3100'

T.D. 3115'

Dry & Abandoned

Clay

62 KANSAS Sec. 19 Twp. 10 R. 3^E

Map No. 1 Well No. 1

Derby Oil Co Company

Contractor

FIRST REPORTS

660 Ft. from N. Line

_____ Ft. from S. Line

_____ Ft. from E. Line

660 Ft. from W. Line

SECTION PLAT

0			

Location ☒

Rig up _____

Drilling and Remarks:

RECORD

Cased _____ in., _____ ft.

Sand _____

Gas _____

Oil _____

Total Depth _____

PRODUCTION

1st 24 hrs. Nat. _____

1st 24 hrs. after shot _____

Gas _____ Cu. Ft.

Dry Hole _____

Abandoned _____

Date

JUL 17 1929

CHAS. L. SHERWOOD

19

Scout

*no final of
warrant*

Returned	<i>OK</i>
Cards	
Tracing	<i>OK</i>
France Map	<i>no map</i>
Scarborough Map	<i>X</i>
Moody Map	
Scarborough Flat Book	
Moody Flat Book	

62 **KANSAS** Sec. 19 Twp. 10 R. 3 E
 Map No. *clay*
 Well No. 1 *Nie Muller*
Derby Oil Co Company
 Contractor


COMPLETE

660 Ft. from N. Line

Ft. from S. Line

Ft. from E. Line

660 Ft. from W. Line

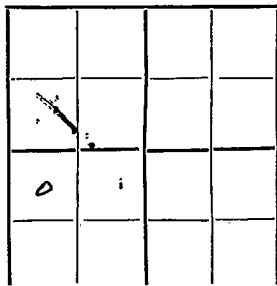SECTION PLAT**ABANDONED**

Location

Rig up

Drilling and Remarks:

HFW 3090-3100

RECORD

Cased in., ft.

Sand

Gas

Oil

Total Depth 3115

PRODUCTION

1st 24 hrs. Nat.

1st 24 hrs. after shot

Gas Cu. Ft.

Dry Hole ✓

Abandoned ✓

Date

JAN 8 1930

CHAS. L. SHERWOOD

192 Scout

no small
no wall up

Returned	
Cards	
Tracing	<i>OK</i>
France Map	<i>7</i>
Scarborough Map	<i>X</i>
Moody Map	
Scarborough Port Book	
Moody Port Book	