


Section 19 Township 10 Range 4E
Well No. #1 Faidley
Company D.T. Ingling et al

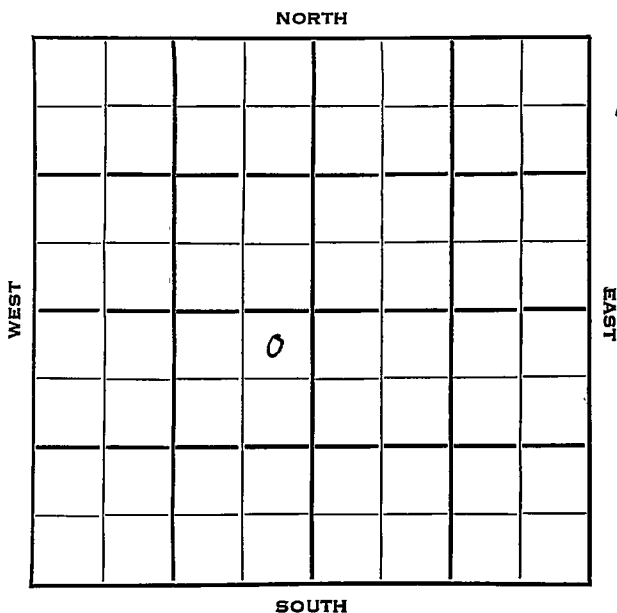

L&S 1180

Clay

KANSAS

SEC.	TWP.	R.
19	10	4E ✓

WELL NO.

1 Faidley

FARM

COMPANY

D. T. Ingling et al

CONTRACTOR

Ingling

Wildcat

330


Ft. from N. Line

Ft. from S. Line

330

Ft. from E. Line

Ft. from W. Line

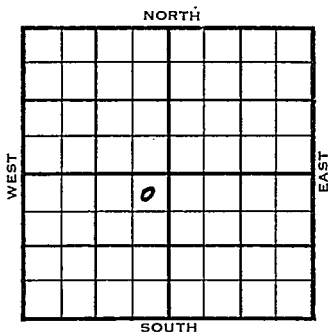

NE NE SW

1953

ELEVATION

= 1180

REPORT

11/4

Spud 10-29-53

8" @ 130'

KC 1500'

Dr1g. 1615'

11/18

Spud 10-29-53

D & A

TD 2858'

8" @ 130'

KC 1500', B KC 1714', Burgess 1882',
 Miss 1900', Hunton 2168', Viola 2554',
 Simp 2692', Arb 2796'

TD 2858'

D & A

ABANDONED

$$\begin{array}{r} 1700 \\ 1714 \\ \hline \end{array}$$

$$\begin{array}{r} 1714 \\ 1180 \\ \hline 534 \end{array}$$

$$\begin{array}{r} 1500 \\ 1180 \\ \hline 320 \end{array}$$


$$\begin{array}{r} 1900 \\ 1180 \\ \hline 720 \end{array}$$

1500

$$\begin{array}{r} 1900 \\ 1714 \\ \hline 186 \end{array}$$

J. G. McGEHEE

County Clay State Kansas
 Sec. 19 (^{Blk.}Twp.) 10 (^{Sur.}Rge.) 4E Map No. _____
 Operator D. T. Ingling et al.
 Well No. 1 Farm Faidley
 Elev. 1180 L&S Location NE NE SW

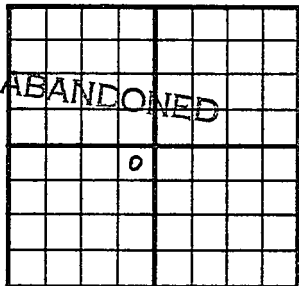

330 Ft. From N Line SW
330 Ft. From E Line Quarter
 Ist. Report _____
 Completion NOV 18 1953
 Remarks Wildcat
Ingling - Contr.
 Spudding Date 10-29-53

Drlg. Data D & A TD 2858
8" @ 130 KC 1500 B KC 1714
Burgess 1882 Miss. 1900 Dunton 2168
Viola 2554 Simp. 2692 Arb. 2796
TD 2858

D & A

J. G. McGEHEE