


Section 19 Township 10 Range 21-E

Well No. 1 Corlett

Company A & B Pipe Line

NORTH Miscellaneous

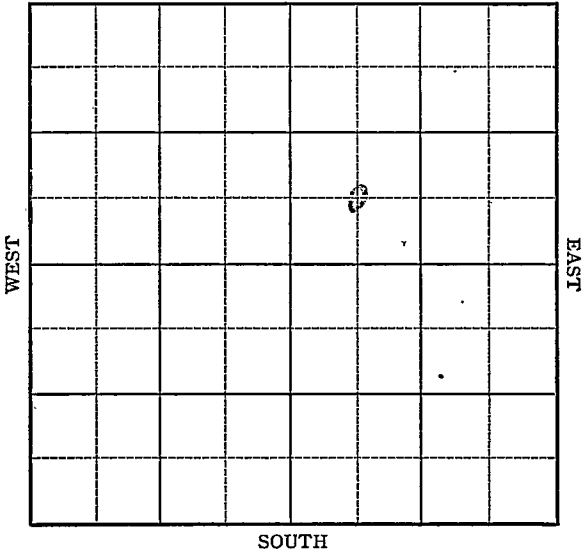

Map No. N/A Sec. 19 Twp. 10 R. 21E

Well No. 1 Corlett

A & B Pipe Line Company

Contractor

FIRST REPORT

C SW NE

7 Ft. from N. Line

660 Ft. from S. Line

 Ft. from E. Line

660 Ft. from W. Line

SECTION PLAT

| | | | |
|--|--|---|--|
| | | | |
| | | o | |
| | | | |
| | | | |

MISCELLANEOUS

Location _____

Rig up _____

Drilling and Remarks:

Machine

RECORD

Cased _____ in., _____ ft.

Sand _____

Gas _____

Oil _____

Total Depth _____

PRODUCTION

1st 24 hrs. Nat. _____

1st 24 hrs. after shot _____

Gas _____ Cu. Ft.

Dry Hole _____

Abandoned _____

Date

OCT 1 1941 19

S. J. LEWIS Scout

Map No. WM Sec. 19 Twp. 10 R. 21EWell No. 1 CorlettA & B Pipe Line CompanyABANDONED Contractor

SECTION PLAT

C SW NE

 Ft. from N. Line660 Ft. from S. Line Ft. from E. Line660 Ft. from W. Line

| | | | |
|--|--|---|--|
| | | | |
| | | o | |
| | | | |
| | | | |

MISCELLANEOUS

Location Rig up

Drilling and Remarks:

*Mis 1417**No show*

RECORD

Cased in., ft.Sand Gas Oil Total Depth 1430

PRODUCTION

1st 24 hrs. Nat. 1st 24 hrs. after shot Gas Cu. Ft.Dry Hole Abandoned

Date

OCT 22 1941 19S. J. LEWIS Scout