


Section 19 Township 10 Range 20-E

Well No. #1 Petria

Company Lauring et al
(Misc.)

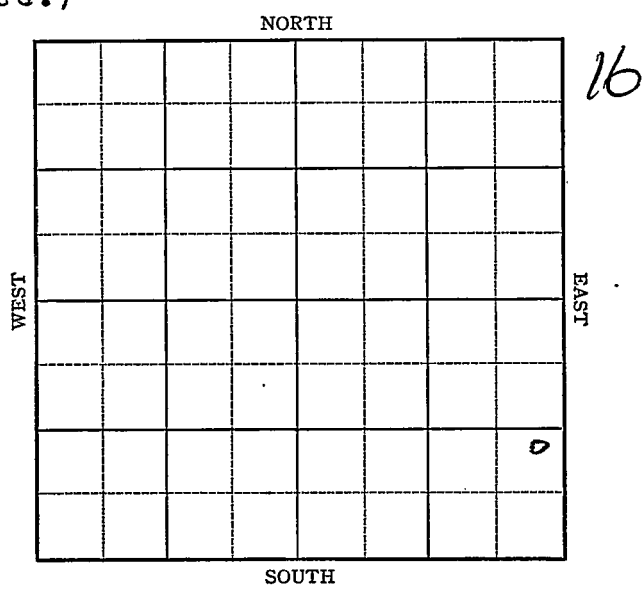


KANSAS

Jefferson

Sec. 19 Twp. 10 R. 20-EWell No. #1 Petria FarmLauring et al Company
(Miscellaneous) Ft. from N. Line990 Ft. from S. Line330 Ft. from E. Line Ft. from W. Line

Elev. 1107

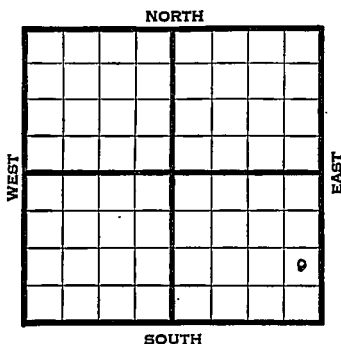

1941

REPORT

8/6

10" - 38

8" - 1141 Drlg.

8/15

Drlg. 1320'

8/21

Miss. 1641' Drlg. 1654'

8/27

Miss. 1555'

T.D. 1642'

No shows.

ABANDONED

KANSASMap No. 111 Sec. 19 Twp. 10 R. 20EWell No. 1 PetriaLauring etal CompanyFIRST REPORT Contractor

NE SE SE

 Ft. from N. Line990 Ft. from S. Line330 Ft. from E. Line Ft. from W. Line

SECTION PLAT

			o

MISCELLANEOUS

Location Rig up

Drilling and Remarks:

10" - 388" - 1141 Drlg.

RECORD

Cased in., ft.Sand Gas Oil Total Depth

PRODUCTION

1st 24 hrs. Nat. 1st 24 hrs. after shot Gas Cu. Ft.Dry Hole Abandoned

Date

AUG 6 1941 19 S. J. LEWIS Scout

Map No. _____ Sec. 19 Twp. 10 R. 20EWell No. 1 PetriaLauring etal

Company _____

Contractor _____

ABANDONED

NE SE SE

_____ Ft. from N. Line

990 Ft. from S. Line330 Ft. from E. Line

_____ Ft. from W. Line

MISCELLANEOUS

SECTION PLAT

			o

Location _____

Rig up _____

Drilling and Remarks:

*Well 1555**No show***RECORD**

Cased _____ in., _____ ft.

Sand _____

Gas _____

Oil _____

Total Depth 1642**PRODUCTION**

1st 24 hrs. Nat. _____

1st 24 hrs. after shot _____

Gas _____ Cu. Ft.

Dry Hole _____

Abandoned _____

Date

AUG 27 1941 19 _____ S. J. LEWIS Scout