

KANSAS


Leavenworth

FORM 51 5M 4-41 PETROL

Section 2 Township 10 Range 20-E

Well No. #1 Fidler

Company McLaughlin et al

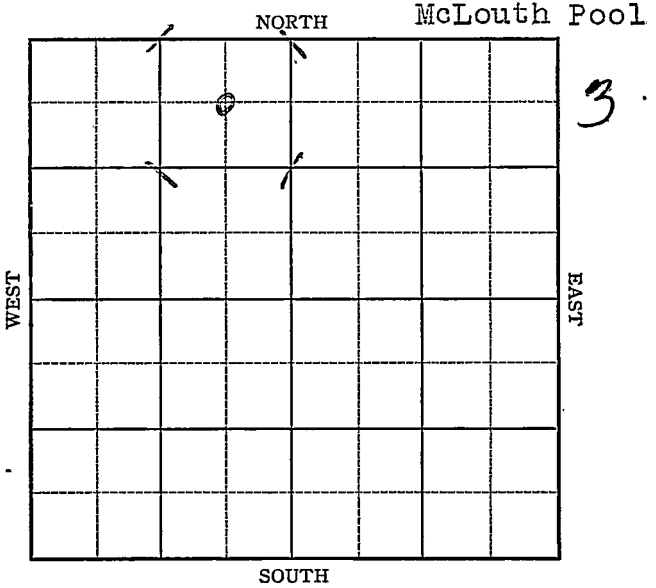

Sec. 2 Twp. 10 R. 20-E

Well No. #1 Fidler Farm

McLaughlin et al Company


(McLouth)

660 Ft. from N. Line

 Ft. from S. Line

660 Ft. from E. Line

 Ft. from W. Line

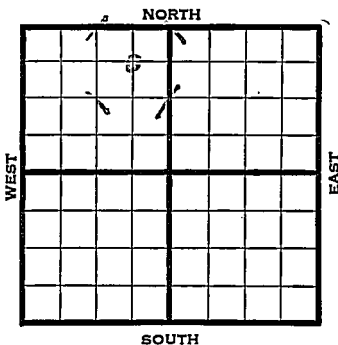

	REPORT
1942	
6/3	Location
6/10	"
6/17	Machine.
6/24	8" - 800' Drlg. 815'
7/1	Bart. 1364' Miss. 1394' T.D.
7/8	Sand 1364'
	Miss. 1394'
	T.D. 1434'
	No shows.
	ABANDONED


Leavenworth KANSAS

Map No. MM Sec. 2 Twp. 10 R. 20EWell No. 1 FidlerMcLaughlin et al. CompanyFIRST REPORT Contractor

C NE NW

660 Ft. from N. Line Ft. from S. Line660 Ft. from E. Line Ft. from W. Line

SECTION PLAT

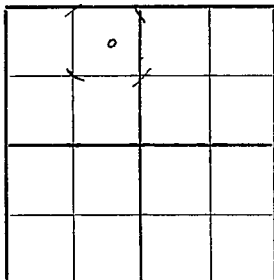

MCLOUTH POOL

Location XXRig up

Drilling and Remarks:

RECORD

Cased in., ft.Sand Gas Oil Total Depth

PRODUCTION

1st 24 hrs. Nat. 1st 24 hrs. after shot Gas Cu. Ft.Dry Hole Abandoned

Date

JUN 3 1942 19S. J. LEWIS Scout

Map No. MM Sec. 2 Twp. 10 R. 20E

Well No. 1 Fidler

McLaughlin et al. Company

ABANDONED

Contractor

C NE NW

660 Ft. from N. Line

_____ Ft. from S. Line

660 Ft. from E. Line

_____ Ft. from W. Line

SECTION PLAT

	o		

ACKERLAND

Location _____

Rig up _____

Drilling and Remarks:

Sand 1864

Mis 1894

No show

RECORD

Cased _____ in., _____ ft.

Sand _____

Gas _____

Oil _____

Total Depth 1434

PRODUCTION

1st 24 hrs. Nat. _____

1st 24 hrs. after shot _____

Gas 1 Cu. Ft.

Dry Hole _____

Abandoned _____

Date

JUL 8 1942 19

S. J. LEWIS Scout