

4-10-206 P

SIDE ONE

STATE CORPORATION COMMISSION OF KANSAS  
OIL & GAS CONSERVATION DIVISION

WELL COMPLETION OR RECOMPLETION FORM  
ACQ-1 WELL HISTORY

DESCRIPTION OF WELL AND LEASE

Operator: license # 8242  
name N.R. Hamm Quarry, Inc.  
address P.O. Box 17  
City/State/Zip Perry, Kansas 66073

Operator Contact Person N. Rodney Hamm  
Phone 913-597-5111

Contractor: license # 6192  
name N.R. Hamm contractor, Inc.

Site Geologist NONE

Original Type of Completion  
 New Well  Re-Entry  Workover

Well Completion Type  
 SWD  Temp Abd  Inj  Delayed Comp.  
 Other (Core, Water Supply etc.)

Old Well Info as follows:  
Operator  
Well Name  
Comp. Date Old Total Depth

WELL HISTORY

Completion Method:  Mud Rotary  Air Rotary  Cable

1-84 2-11-84 2-11-84  
Date Date Reached TD Completion Date  
1700  
1699  
h PBTD

Depth of Surface Pipe Set and Cemented at 506 feet

Single Stage Cementing Collar Used?  Yes  No

If Yes, Show Depth Set feet

Rate 2 completion, cement circulated  
feet depth to w/ SX cmt

API NO. 15-087-20074

County Jefferson

NE 1/4 Sec 4 Twp 10 Rge 20 East West

2080 South from N. Line  
990 Ft North from Southeast Corner of Section  
Ft West from Southeast Corner of Section  
(Note: locate well in section plat below)

Lease Name Rollins Well# 3


Field Name MCLOUTH

Producing Formation Burlington-Keokuk

Elevation: Ground KB

Section Plat

JUL 25 1986  
KANSAS GEOLOGICAL SURVEY  
WICHITA DIVISION

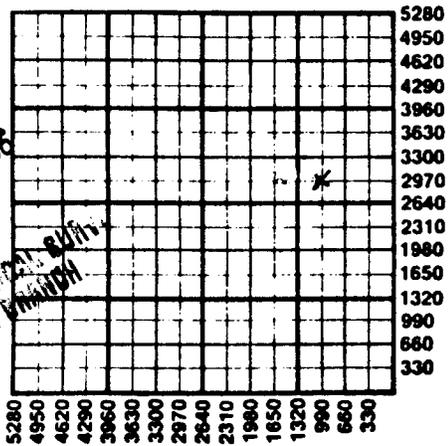

WATER SUPPLY INFORMATION

Source of Water:

Division of Water Resources Permit #

Groundwater Ft North From Southeast Corner and  
(Well) Ft West From Southeast Corner of  
Sec Twp Rge East West

Surface Water Ft North From Southeast Corner and  
(Stream, Pond etc.) Ft West From Southeast Corner  
Sec Twp Rge East West

Other (explain)  
(purchased from city, R.W.D.#)

Disposition of Produced Water:  Disposal  Repressuring

Docket #

INSTRUCTIONS: This form shall be completed in duplicate and filed with the Kansas Corporation Commission, 200 Colorado Derby Building, Topeka, Kansas 67202, within 90 days after completion or recompletion of any well. Rules 82-3-130 and 82-3-107 apply.

SIDE TWO

Operator Name N.R. Hamm Quarry, Inc. Lease Name Rollins Well# 3 SEC. 4 TWP. 10. RGE. 20.  East  West

WELL LOG

**INSTRUCTIONS:** Show important tops and base of formations penetrated. Detail all cores. Report all drill stem tests during interval tested, time tool open and closed, flowing and shut-in pressures, whether shut-in pressure reached static level, hydrostatic pressures, bottom hole temperature, fluid recovery, and flow rates if gas to surface during test. Attach extra sheet if more space is needed. Attach copy of log.

Drill Stem Tests Taken  Yes  No  
 Samples Sent to Geological Survey  Yes  No  
 Cores Taken  Yes  No

Formation Description  
 Log  Sample

Name	Top	Bottom
McLouth Sand	1446	1462
Mississippian	1484	

.....2.....	.1655.....1661.....	.500 GAL. 15% HCL.....	.655-1661..
.....	.....	.....	.....
.....	.....	.....	.....
.....	.....	.....	.....

Logging Record size NONE set at packer at Liner Run  Yes  No

Date of First Production Producing method  flowing  pumping  gas lift  Other (explain) ..TA.....

Estimated Production Per 24 Hours	Oil	Gas	Water	Gas-Oil Ratio	Gravity
	Bbls	MCF	Bbls	CFPB	

RECEIVED  
 STATE CORPORATION COMMISSION  
 CONS. DIV. WICHITA, KS

Position of gas:  vented  sold  used on lease  
 METHOD OF COMPLETION  open hole  perforation  other (specify) .....  
 Dually Completed.  Commingled  
 PRODUCTION INTERVAL JUL 23 1985 1655 1661

CASING RECORD <input type="checkbox"/> new <input type="checkbox"/> used							
Report all strings set - conductor, surface, intermediate, production, etc.							
Purpose of string	size hole drilled	size casing set (In O.D.)	weight lbs/ft.	setting depth	type of cement	# sacks used	type and percent additive
..... Surface	12 1/2.....	8 5/8.....	22.....	.506.....	Class. A...	300.....	3% CAL.....
..... Prod...	5 7/8.....	5 1/2.....	14.....	.1699.....	Class. A...	350.....	3% CAL.....
.....	.....	.....	.....	.....	.....	.....	.....
.....	.....	.....	.....	.....	.....	.....	.....

PERFORATION RECORD specify footage of each interval perforated  
 Acid, Fracture, Shot, Cement Squeeze Record (amount and kind of material used) Depth