

EFFECTIVE DATE
DISTRICT#
SGA?...Yes...No

Must be approved by the K.C.C. five (5) days prior to commencing well

FORM MUST BE TYPED
FORM MUST BE SIGNED
ALL BLANKS MUST BE FILLED

11-17-93
EXPECTED SPUD DATE: 11 24 93
month day year
Operator: License #: 03133
Name: KLM EXPLORATION, INC.
Address: BOX #151
City/State/Zip: MCLOUTH KS. 66054
Contact Person: JIM BOLINGER
Phone: 913-796-6763

CONTRACTOR: License # 05786
Name: MCGOWN DRILLING, INC.

Well Drilled For: Well Class: Type Equipment:

XX Oil ___ Enh Rec ___ Infield XX Mud Rotary
___ Gas ___ Storage ___ Pool Ext. ___ Air Rotary
___ OWWO ___ Disposal XX Wildcat ___ Cable
___ Seismic; ___ # of Holes ___ Other
___ Other

If OWWO: old well information as follows:

Operator: _____
Well Name: _____
Comp. Date: _____ Old Total Depth _____

Directional, Deviated or Horizontal wellbore? ___ yes XX no
If yes, true vertical depth: _____
Bottom Hole Location _____

Spot
NW NW NE Sec 07 Twp 10 S, Rg 20 EE EAST
4950 feet from (South) / North Line of Section
2310 feet from (East) / West Line of Section
IS SECTION XX REGULAR ___ IRREGULAR?
NOTE: Locate well on the Section Plat on Reverse Side)
COUNTY: JEFFERSON
LEASE NAME: WALBRIDGE WELL#: 2
Field Name: WILDCAT
Is this a Prorated/Spaced Field? ___ yes XX no
Target Formation(s): PENN-MCLOUTH
Nearest lease or unit boundary: 330
Ground Surface Elevation: NA feet MSL
Water well within one-quarter mile: ___ yes XX no
Public water supply well within one mile: ___ yes XX no
Depth to bottom of fresh water: 200
Depth to bottom of usable water: 275
Surface Pipe by Alternate: ___ 1 XX 2
Length of Surface Pipe Planned to be set: 200
Length of Conductor Pipe required: NONE
Projected Total Depth: 1600
Formation at Total Depth: TOP MISSISSIPPI
Water Source for Drilling Operations: ___ well ___ farm pond XX other
DWR Permit# _____
Will Cores Be Taken? ___ yes XX no
If yes, proposed zone: _____

AFFIDAVIT

The undersigned hereby affirms that the drilling, completion and eventual plugging of this well will comply with Kansas Conservation Commission et. seq.
It is agreed that the following minimum requirements will be met:

1. Notify the appropriate district office prior to spudding of well.
2. A copy of the approved notice of intent to drill shall be posted on each drilling rig:
3. The minimum amount of surface pipe as specified below shall be set by circulating cement to the top: in all cases, surface pipe shall be set through all unconsolidated materials plus a minimum of 20 feet into the underlying formation.
4. If the well is dry hole, an agreement between the operator and district office on plug length and placement is necessary prior to plugging.
5. The appropriate district office will be notified before well is either plugged or production casing is cemented in:
6. IF AN ALTERNATE II COMPLETION, PRODUCTION PIPE SHALL BE CEMENTED FROM BELOW ANY USABLE WATER TO SURFACE WITHIN (120) DAYS OF SPUD DATE. IN ALL CASES, NOTIFY DISTRICT OFFICE PRIOR TO ANY CEMENTING.

I hereby certify that the statements made herein are true and to the best of my knowledge and belief.

Date: 11/09/93 Signature of Operator or Agent: Marilyn E. Fox Title AGENT
SEARCH INC., 316-268-5415

1004

FOR KCC USE:	087-20497
API # 15-	
Conductor Pipe required	None feet
Minimum surface pipe required	20 feet per Alt. X2
Approved by:	CLB 11-12-93
This Authorization expires:	5-12-94
(This authorization void if drilling not started within 6 months of effective date.)	
Spud date:	Agent:

REMEMBER TO:

- File Drill Pit Application (form CDP-1) with intent to Drill;
- File Completion Form ACO-1 within 120 days of spud date;
- File acreage attribution plat according to field proration orders;
- Notify appropriate district office 48 hour prior to workover or re-entry;
- Submit plugging report (CP-4) after plugging is completed;
- Obtain written approval before disposing or injecting salt water.

Mail to: Conservation Division, 200 Colorado Derby Building, 202 W. First St., Wichita, Kansas 67202-1286.

RECEIVED
KANSAS CORPORATION COMMISSION

NOV 09 1993

7
10
20

KLM
BOX 151
MCLOUTH, KS 66054

SECTION PLAT SHEET


REV. 11-15-93 WELL #2

OWNER D. HEDGE PATH LEASE

DATE AUG. 6, 1993

SECTION 30 TOWNSHIP 9 S RANGE 20 E

COUNTY JEFFERSON STATE KANSAS SCALE 1" = 660'

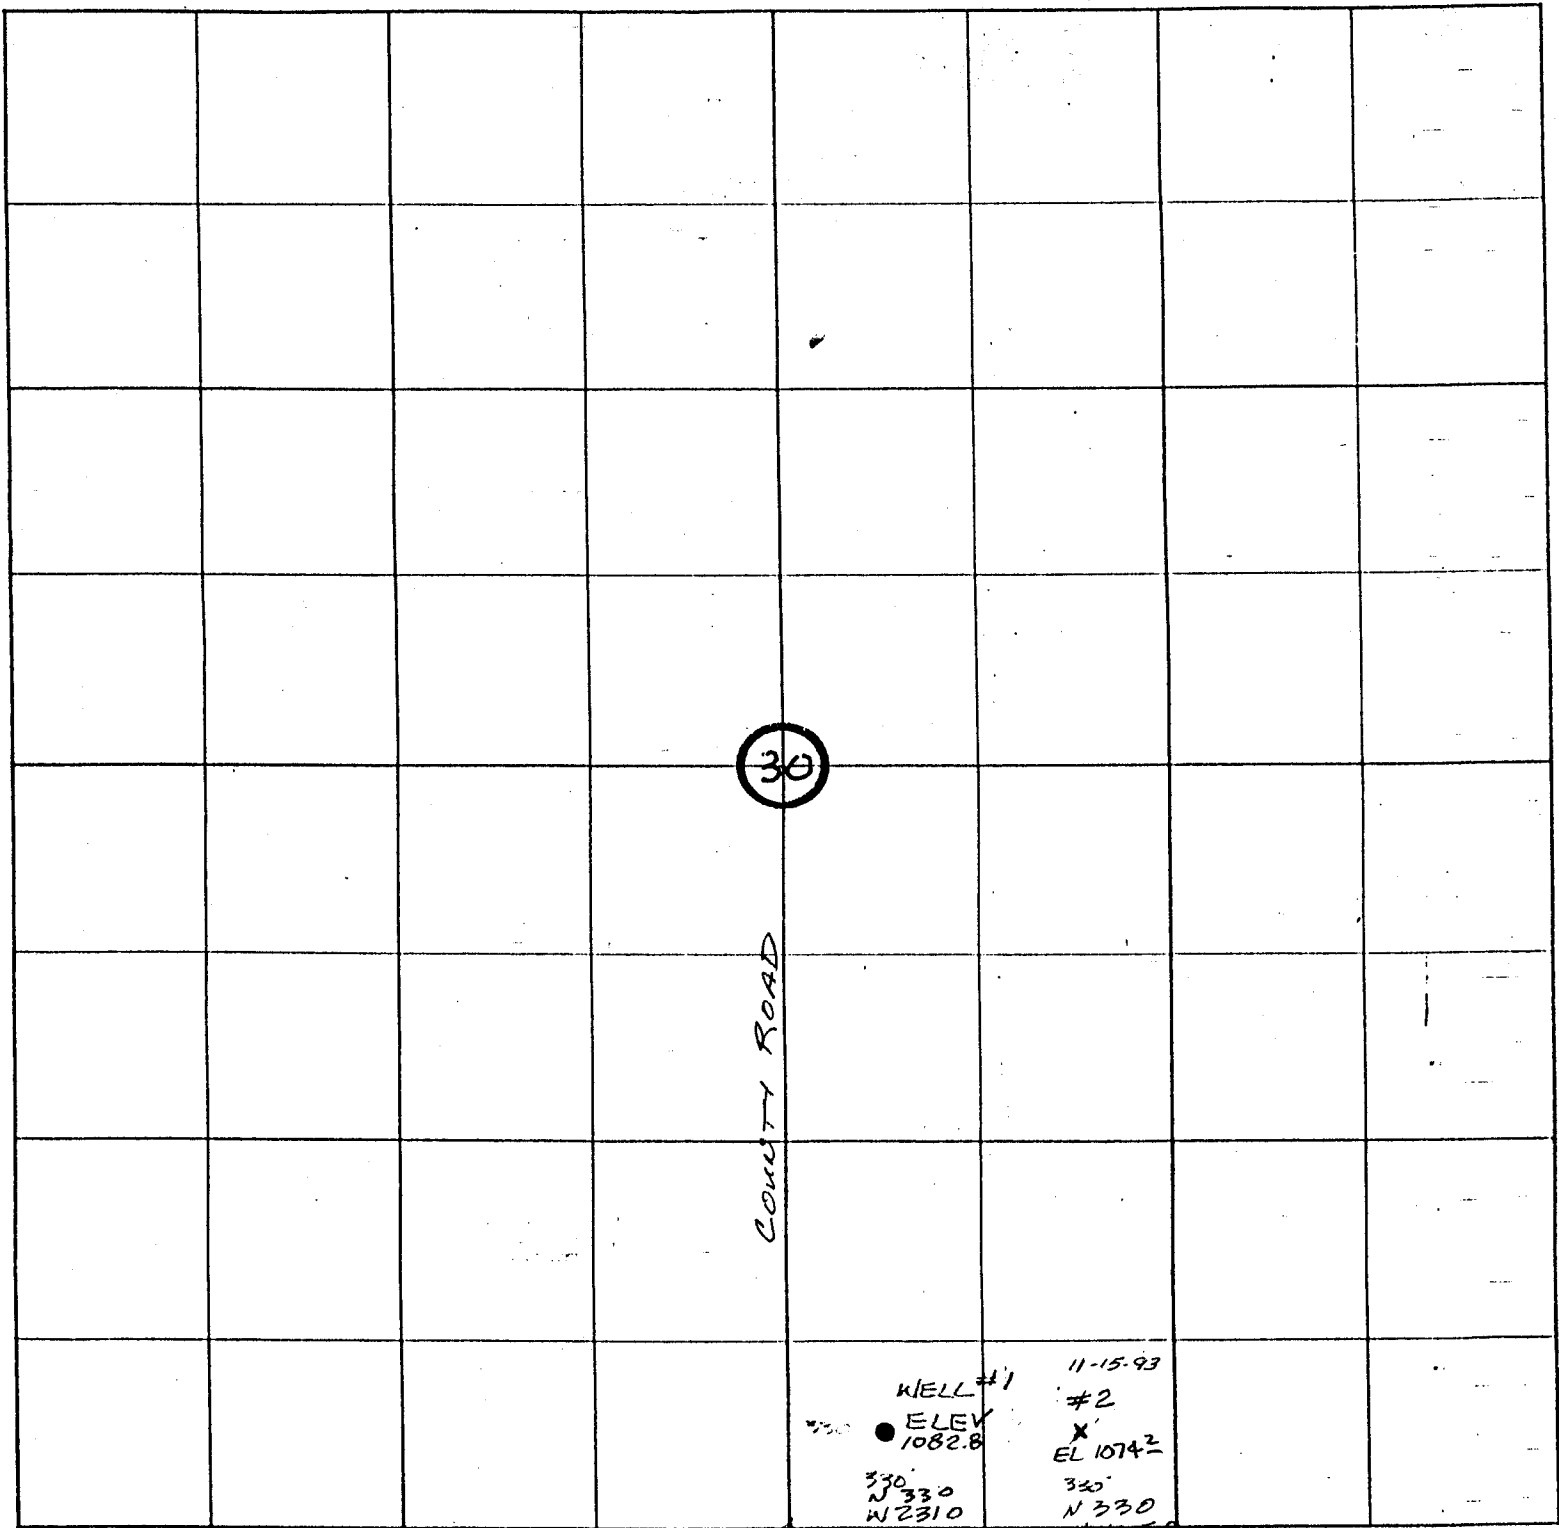

BM ELEV 1137.6
3/4 COR OF 31-9-20

D.G. WHITE & ASSOCIATES
Engineering & Surveying
P. O. Box 192 Lansing, KS 66043
(913) 727-1007